

WATER SERVICE RECORD

Name Moore Homes, Inc.

Service No. 65

Address 55 Paul Revere Rd.

Location

~~Repair Work~~ - New Service DeFlice #2893

JUN 20 1977


Date		Material	Amount		Total	Date	Amount
12/9/76		labor	89.	56		12/7/76	Deposit 200. 00
		10%OH	8.	96	98. 52	6/20/77	Refund 9. 73
	33'	1" copper @ .83			27. 39		190. 27
	1	1" corp.			16. 69		
	1	1" curb.			18. 67		
	1	curb box and rod			13. 00		
	1	hr. trucking @ 3.00			3. 00		
	2	hrs. shovel @ 6.50			13. 00		
					190. 27		
3/14/77	40'	1" copper					

DATE _____

TOWN OF LEXINGTON — BOARD OF PUBLIC WORKS

WATER DIVISION

Sketch of Service Here

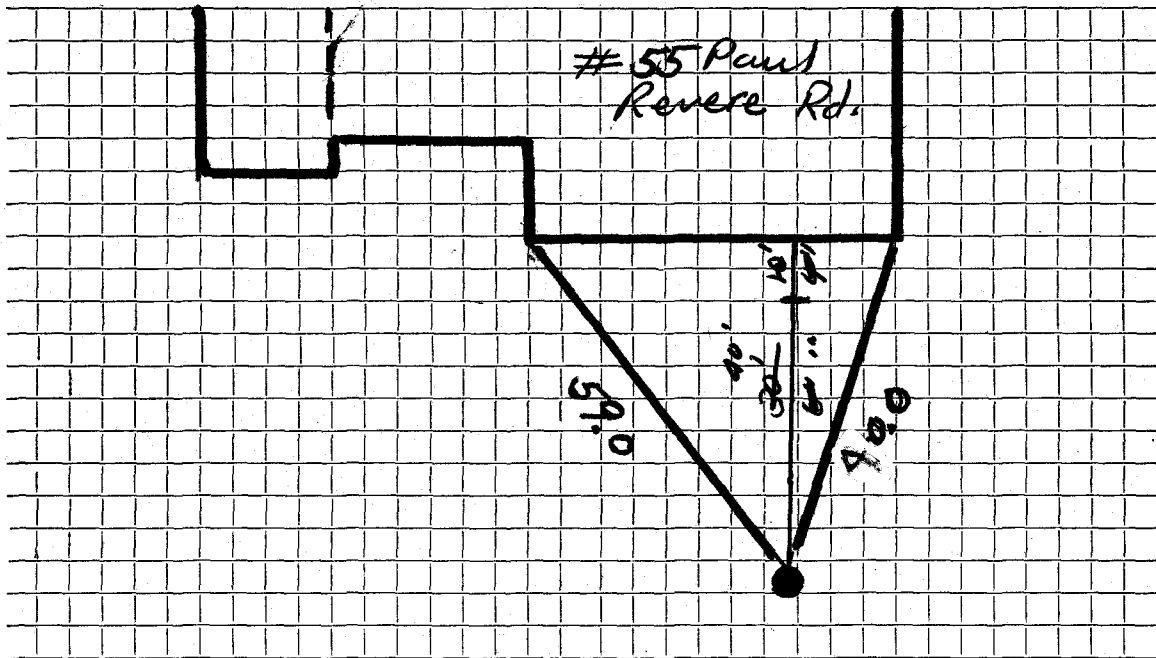

Connection made in Street. Work completed

Remarks:

.....

.....