

WATER SERVICE RECORD

Name Moore Homes, Inc.

Service No. 69

Address 57 Paul Revere Rd.

JUN 20 1977

Location

~~Repair Renewal~~ New Service DeFlice Bros. #2892


Date	Material	Amount	Total	Date	Amount
12/15/76	labor	81. 04		12-7-76	Deposit
	10%OH	8. 10	89. 14	6-30-77	Ret. Fund
14	copper @ .83		11. 62		
1	1" corp.		16. 69		
1	curb.		18. 67		
1	box and rod		13. 00		
1	hr. shovel @ 6.50		6. 50		
2	hrs. loader @ 4.00		8. 00		
			163. 62		

DATE _____

TOWN OF LEXINGTON — BOARD OF PUBLIC WORKS

WATER DIVISION

Sketch of Service Here

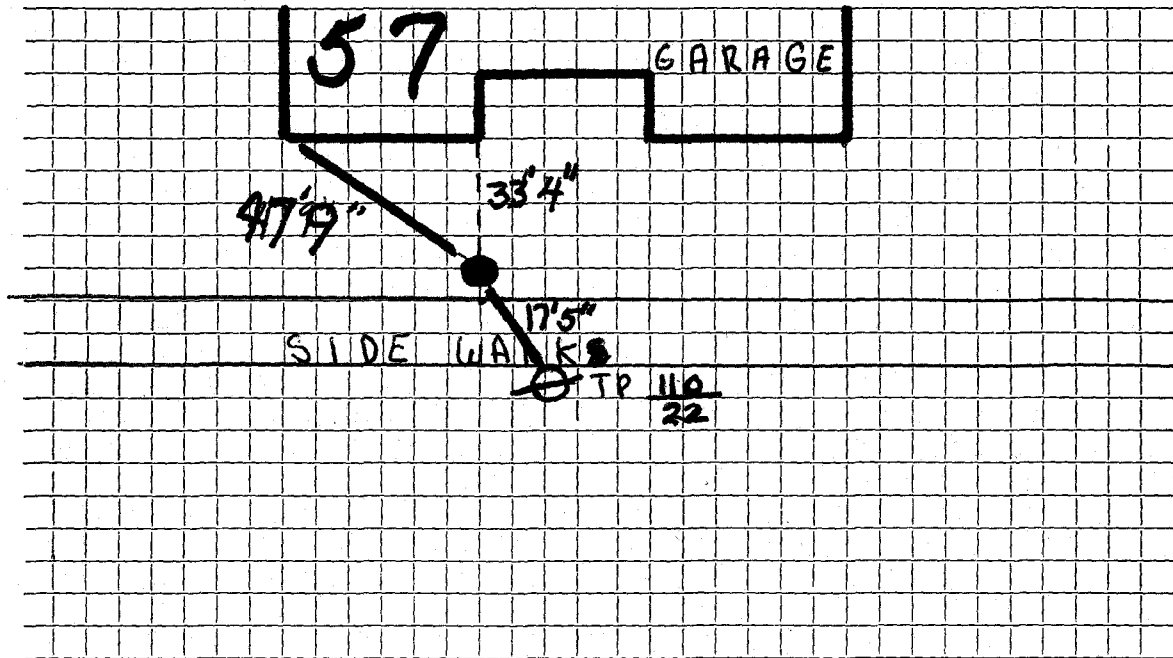

Connection made in Street. Work completed

Remarks:

.....
.....