

WATER SERVICE RECORD

Name

Service No.

Address 58 Paul Revere Road

Location Lexington

Repair ~~Renewal~~ New Service


Date	Material	Amount	Total	Date	Amount
10-27-52	60' 3/4" Copper				
	1 3/4" C. X 1/2" I.W.H.	STop + Waste			
				5/26/52	NON CHARGE Labor 9 06
				30' - 3/4" Copper tubing@.326	9 78
				1 - 3/4" C. Corp cock	4 33
				1 - 3/4" C x 3/4" C. curb-cock	4 67
				1 box and rod	4 68
				2 hrs. Littlefield shovel	14 00
				1 hr. trucking	75
					47 27

DATE _____

TOWN OF LEXINGTON — BOARD OF PUBLIC WORKS

WATER DIVISION

Sketch of Service Here

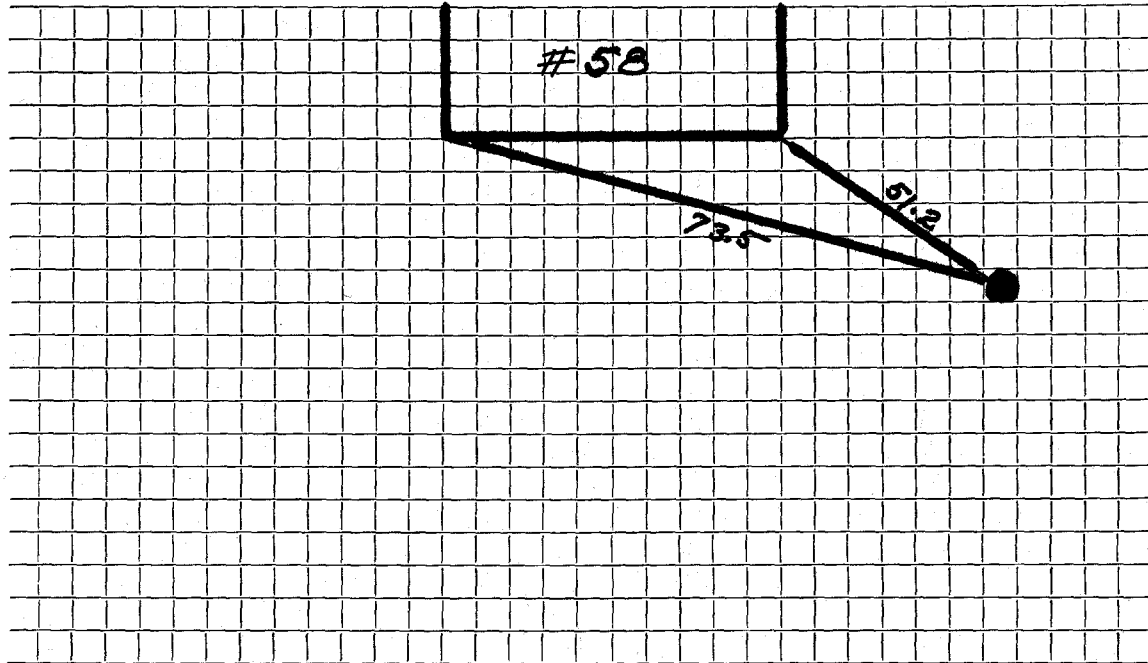

Connection made in Street. Work completed

Remarks:
.....
.....