




DATE \_\_\_\_\_

TOWN OF LEXINGTON — BOARD OF PUBLIC WORKS

WATER DIVISION

Sketch of Service Here

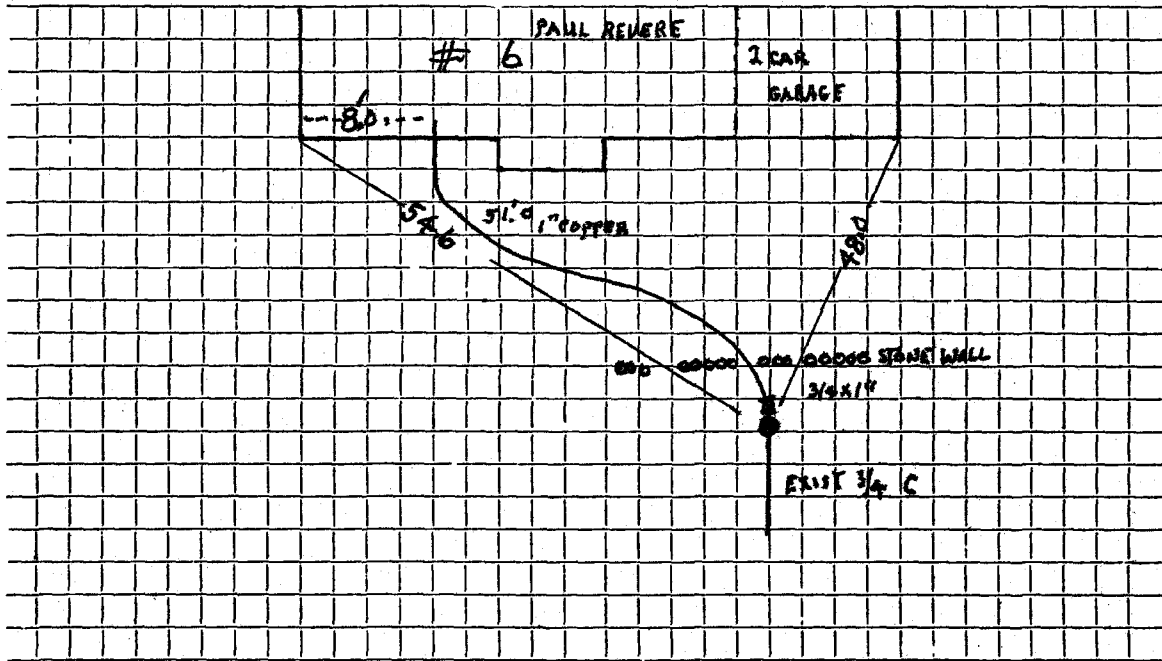

Connection made in ..... Street. Work completed .....

Remarks: .....

.....

.....

Name Ross Realty Corp.,

Service No. ~~107~~ 2186

Address Bedford St., Lexington, Mass.  
6 Paul Revere Rd

#3257

Location

6 Paul Revere Road

Kind of Pipe

Size

Size of Main

~~Repairs-Renewal~~—New Service

Location

Date  
1941

Material

Amount

Total

Date

Amount

Sept. 10,

2 hrs. @ 60

1 20

Sept. 20, 1941 Paid

12 35

10% Overhead

12

1 32

37' 3/4" Copper tubing @ 19¢

19¢

7 03

1 3/4" S., & W.

2 50

2 hrs. trucking @ 75¢

1 50

12 35

Sept 17, 1941 Bell sent,

Labor

Hadley Press, Inc., Lexington

DATE \_\_\_\_\_

# TOWN OF LEXINGTON—BOARD OF PUBLIC WORKS

## WATER DIVISION

The undersigned applies for a supply of water at No. \_\_\_\_\_ St. and hereby agrees to comply with the rules and regulations as now, or at any future time, established by the Board of Selectmen.

Am't. of Estimate \$ \_\_\_\_\_


Owner \_\_\_\_\_

Am't. Paid \$ \_\_\_\_\_

Address \_\_\_\_\_

Builder \_\_\_\_\_

Sketch of Service Here

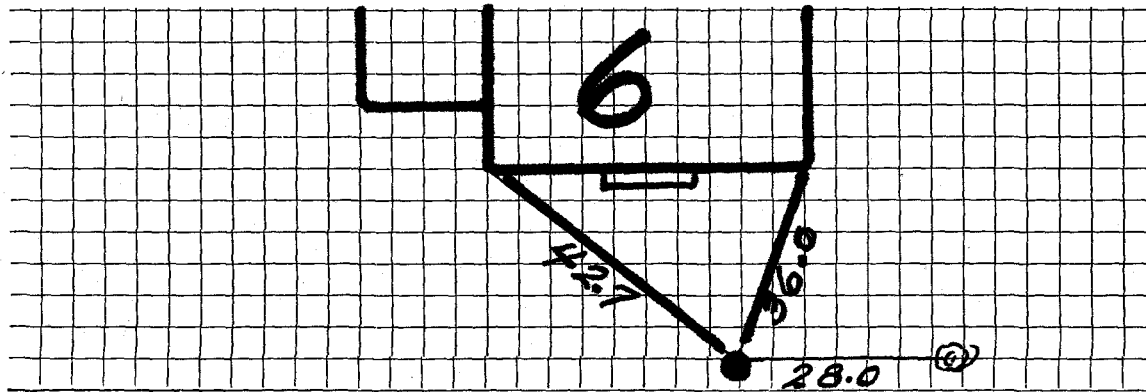

Connection made in \_\_\_\_\_ Street.

Work completed \_\_\_\_\_ 19

Remarks: