

Name Le land Constructi on Co.

## WATER SERVICE RECORD

Service No. 87

#1722

Address 64 Paul Revere Road

Location Lexington

Repair—Renewal—New Service

Com 7-28-52


Date	Material	Amount	Total	Date	Amount
6/6/52	Labor	8 54		5-15-52 Deposited	50 00
	10% Overhead	85	9 39	7-28-52 Re-fund	(4 67)
	50' - 3/4" Copper tubing@.3439	17 19			<u>NON CHARGE</u>
	1 - 3/4" C x 1/2 I.W.H. Stop&Waste	4 00		5/9/52 Labor	25 07
	2 hrs. Littlefield shovel	14 00		32' - 3/4" Copper tubing@.3439	11 00
	1 hr. trucking	75		1 - 3/4" C. Corp-cock	4 33
			45 33	1 - 3/4" C x 3/4" C. Curb-cock	4 67
				1 Box and Rod	4 52
				1 - 1/2 offset tail piece	50
				1 - 1/2 straight tail piece	50
				2 hrs. Town Shovel	10 00
				1 hr. trucking	75
					<u>61 34</u>

DATE \_\_\_\_\_

TOWN OF LEXINGTON — BOARD OF PUBLIC WORKS

**WATER DIVISION**

Sketch of Service Here

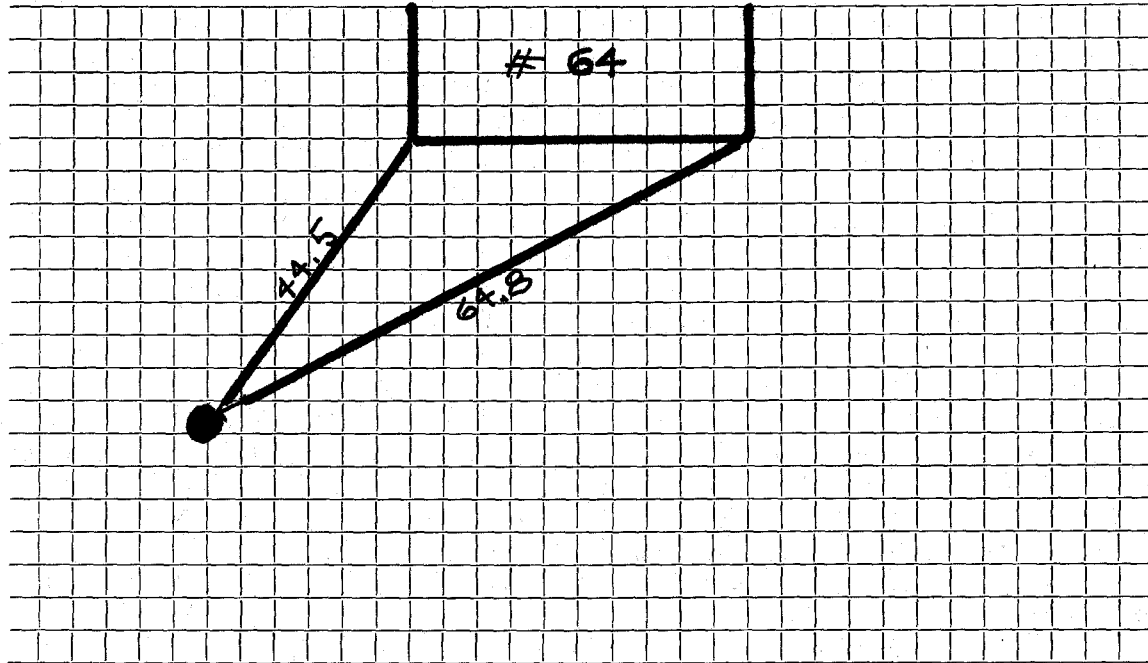

Connection made in ..... Street.                      Work completed .....

Remarks: .....  
.....  
.....