

WATER SERVICE RECORD

Name *John King*

Service No.

Address *67 Paul Revere Road*

Location

~~Repair~~ ~~Renewal~~ — New Service *Valeri #4130*

Date		Material	Amount	Total	Date	Material	Amount
<i>9/5/85</i>	<i>87'</i>	<i>1" Copper</i>					
		<i>1" Valve</i>					
						<i>OUTSIDE</i>	
					<i>9/5/85</i>	<i>19' 1" Copper</i>	
						<i>1 1" Corp</i>	
						<i>1 1" Curb</i>	
						<i>1 Box & Rod</i>	

DATE _____


TOWN OF LEXINGTON — BOARD OF PUBLIC WORKS

WATER DIVISION

Sketch of Service Here

Paul Revere

67

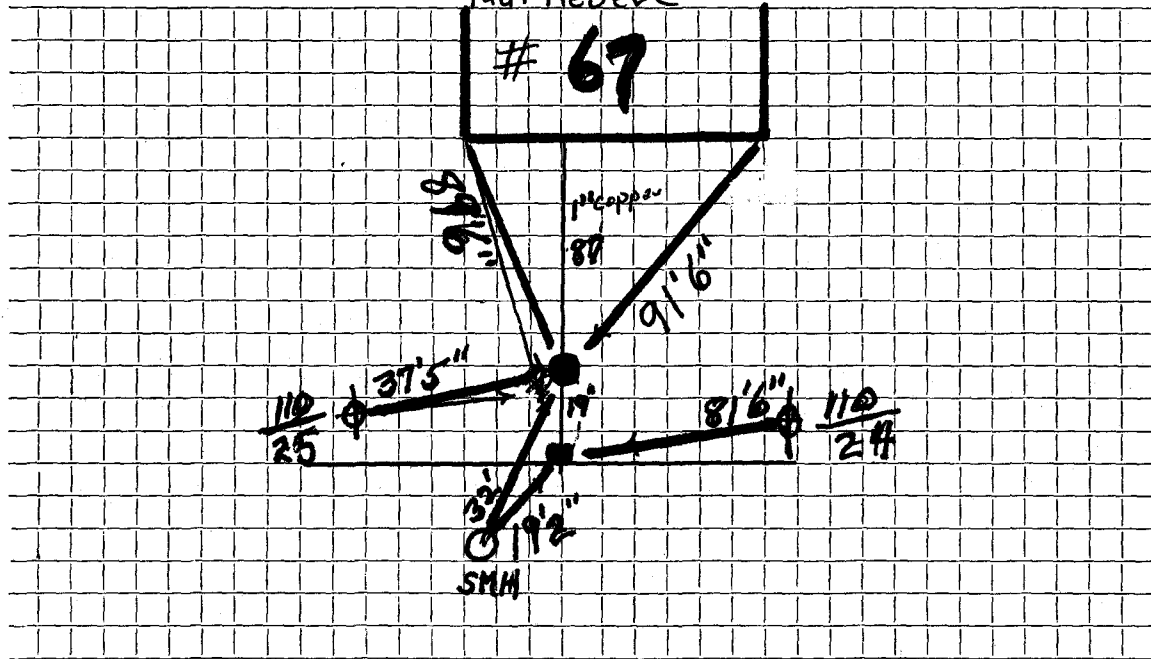

Connection made in Street. Work completed

Remarks:

.....
.....