

Name Howard D. Adams

Service No. 180

Address 69 Paul Revere Road

367

Lexington, Mass.

Location 69 Paul Revere Road

Kind of Pipe

Size

Size of Main

~~XXXXXX~~ New Service

Com. 12-13-49

Location

Date	Material	Amount	Total	Date	Amount
Nov. 18, '49	Labor	6 97	6 97	Aug 29 '49	Deposited 25 00
	10% Overhead		70	Oct 22 '49	Refunded 30 14
	74' - 3/4" Copper Tubing @ .24	17 76			No Charge 44 86
	1 - 3/4"C x 1/2" I.W.H. S&W	3 29		Nov. 17, '49	Labor 6 53
	1 - 3/4"C x 3/4"C Union (3pts)	1 39			10' - 3/4" Copper Tubing @ .24 2 40
	Littlefield Shovel 2 hrs. @ 7.00	14 00			1 - 3/4"C Corp-cock 3 15
	Trucking 1 hr. @ .75		75		1 - 3/4"C x 3/4"C Curb-cock 3 85
			144 86		1 - Box & Rod 3 75
					1 - 1/8" Offset Tail Piece 37
					1 - 1/8" Straight Tail Piece 37
					Littlefield Shovel 2 1/2 hrs. @ 7.00 17 50
					Trucking 1 hr. @ .75 75
	Labor				38 67

DATE _____

TOWN OF LEXINGTON - BOARD OF PUBLIC WORKS

WATER DIVISION

The undersigned applies for a supply of water at No..... St. and hereby agrees to comply with the rules and regulations as now, or at any future time, established by the Board of Selectmen.

Am't of Estimate \$.....

Owner


Am't Paid \$.....

Address

Builder

.....

Sketch of Service Here

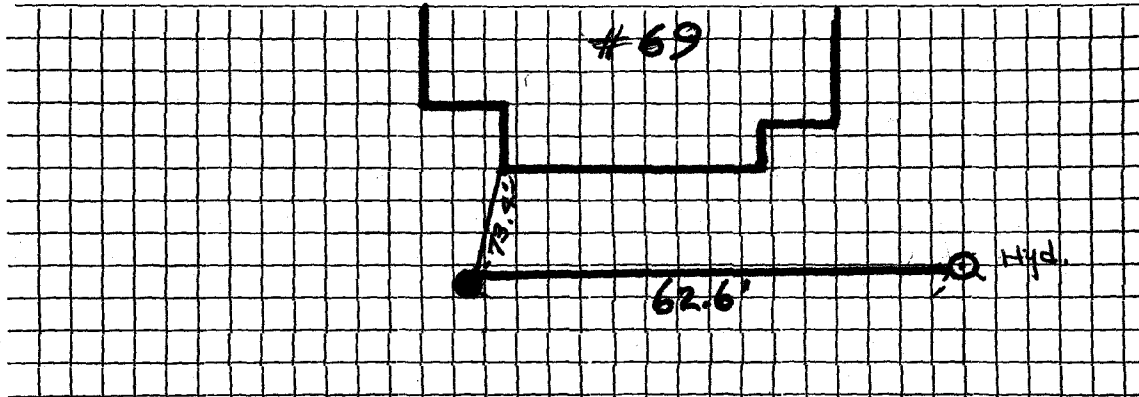

Connection made in Street.

Work completed19

Remarks: