

WATER SERVICE RECORD

Name

Service No.

Address

7 Paul Revere Road

708

Location

Repair - ~~Re~~ Re ~~Installation~~ Installation


Date	Material	Amount	Total	Date	Amount
7-19-41					
	45' 3/4" Copper				
	1 3/4" C.X. Stop & Waste				
	1 3/4" C. 3 Part Union				
					NON CHARGE
				7/15/57	Labor 2 04
				1 3/4"	C Corp Cock 4 64
				2 3/4"	Style 88 Couplings 2 48
				8' - 3/4"	Copper tubing 3 00
				1 Hr.	Trucking @.75 75
					<u>12 91</u>

DATE _____

TOWN OF LEXINGTON — BOARD OF PUBLIC WORKS

WATER DIVISION

Sketch of Service Here

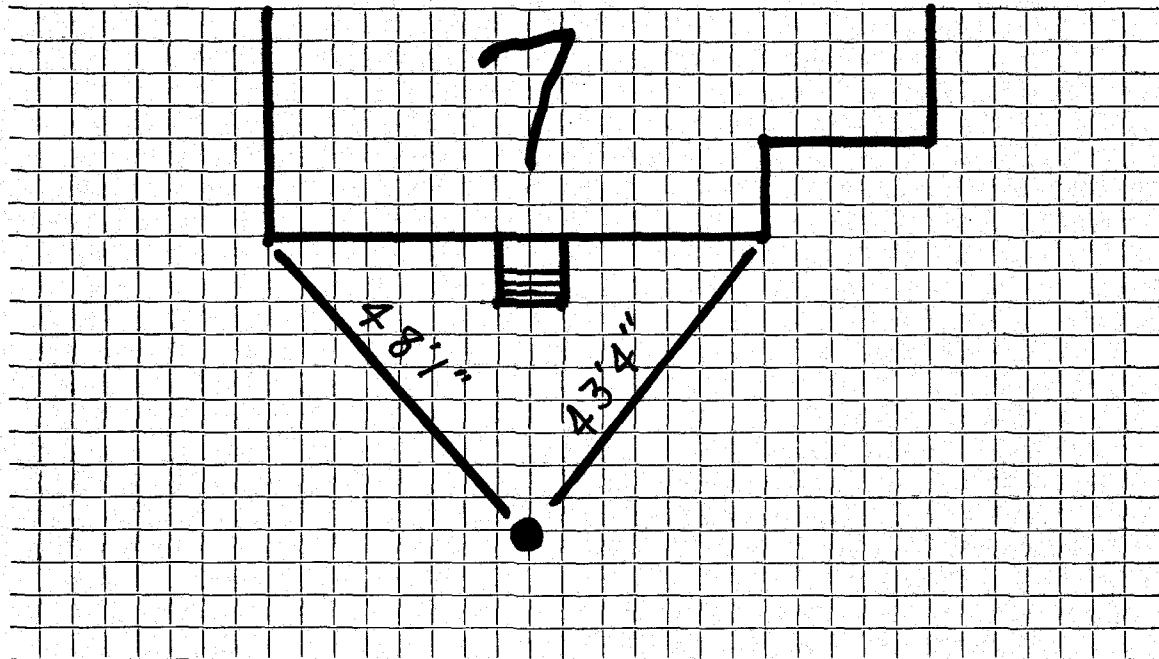

Connection made in Street. Work completed

Remarks:

.....

.....