

Name John Anderson

Service No. 49

Address 73 Paul Revere Road

3835

Lexington, Mass.

Location 73 Paul Revere Road

Kind of Pipe

Size

Size of Main

~~REPAIR~~ ~~RENEWAL~~ - New Service

Com. 8-23-48

Location

Date	Material	Amount	Total	Date	Amount
June 3, '48	Labor	6 90	6 90	May 25 '48	50 00
	10% Overhead		69	July 20 '48	3 23
	56' - 3/4" Copper Tubing @ .255	14 28			46 77
	1 - 3/4" C x 1/2" I.W.H. S & W	3 15		June 3, '48	Labor
	Littlefield Shovel 3 hrs. @ 7.00	21 00			5 92
	Trucking 1 hr. @ .75		75	7' - 3/4" Copper Tubing @ .255	1 79
			46 77	1 - 3/4" C Corp-cock	3 00
				1 - 3/4" C x 3/4" C Curb-cock	3 68
				1 - 1/2" Straight Tail Piece	30
				1 - 1/2" Offset Tail Piece	30
				Littlefield Shovel 1/2 hr. @ 7.00	3 50
				Trucking 1 hr. @ .75	75
					22 79
	Labor				

Deposited
 Refunded
 Non-Charge

DATE _____

TOWN OF LEXINGTON—BOARD OF PUBLIC WORKS

WATER DIVISION

The undersigned applies for a supply of water at No. _____ St. and hereby agrees to comply with the rules and regulations as now, or at any future time, established by the Board of Selectmen.

Am't. of Estimate \$ _____

Owner _____


Am't. Paid \$ _____

Address _____

Builder _____

163 Willow Ave. Somerville

Sketch of Service Here

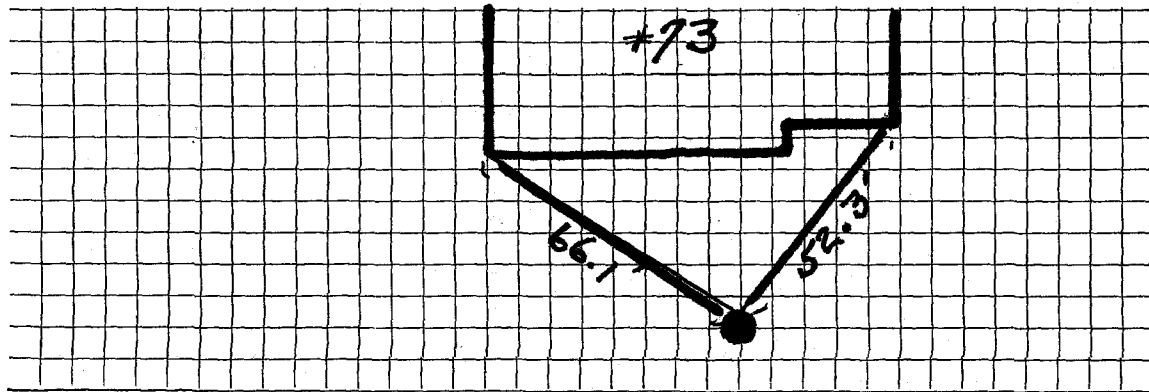

Connection made in _____ Street.

Work completed _____ 19

Remarks: