


DATE 11-14-00

TOWN OF LEXINGTON — BOARD OF PUBLIC WORKS

WATER DIVISION

Sketch of Service Here

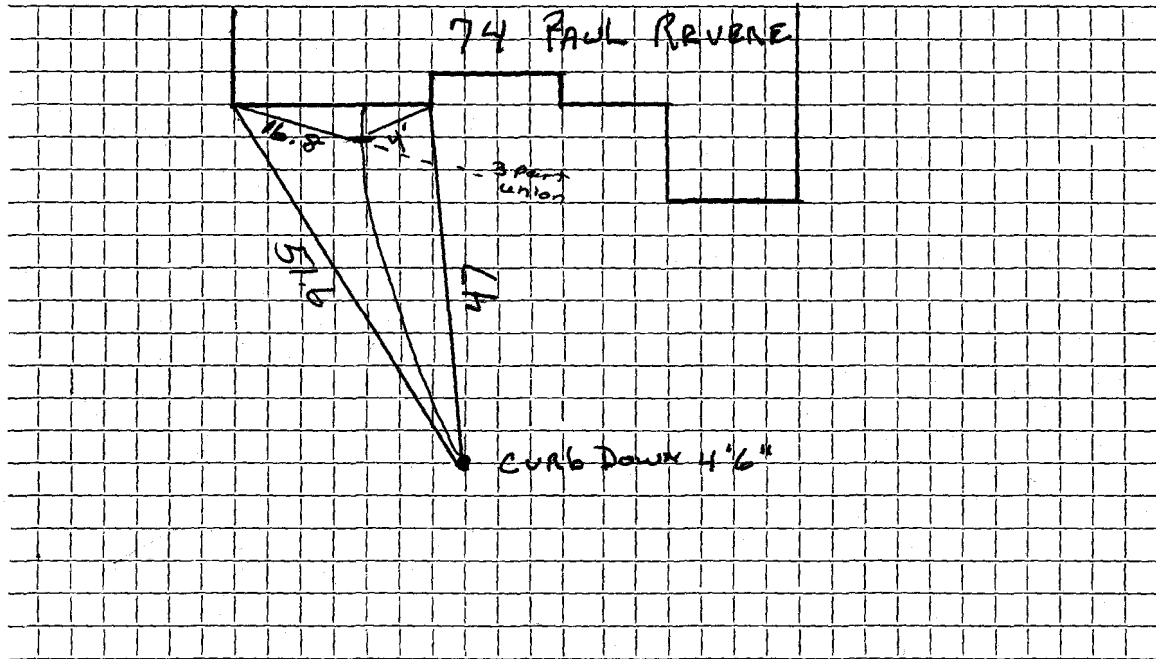

Connection made in Street. Work completed

Remarks: 3 part union... 3' OFF. Foundation Wall).....

..... INSTALLED BY P. ROSE