

WATER SERVICE RECORD

Name

Service No.

Address

Location 76 PAUL REVERE WAD 74 CEDAR

Repair—Renewal—New Service UPGRADE McLaughlin

Date Material Amount Total Date Amount


JUNE 1-99	38'	1" COPPER			5/23/51	21'	3/4 COPPER		
	1	3/4x1" UNION				1	3/4 COP		
		Bufflo Box				1	3/4 CURB		

DATE _____

TOWN OF LEXINGTON — BOARD OF PUBLIC WORKS

WATER DIVISION

Sketch of Service Here

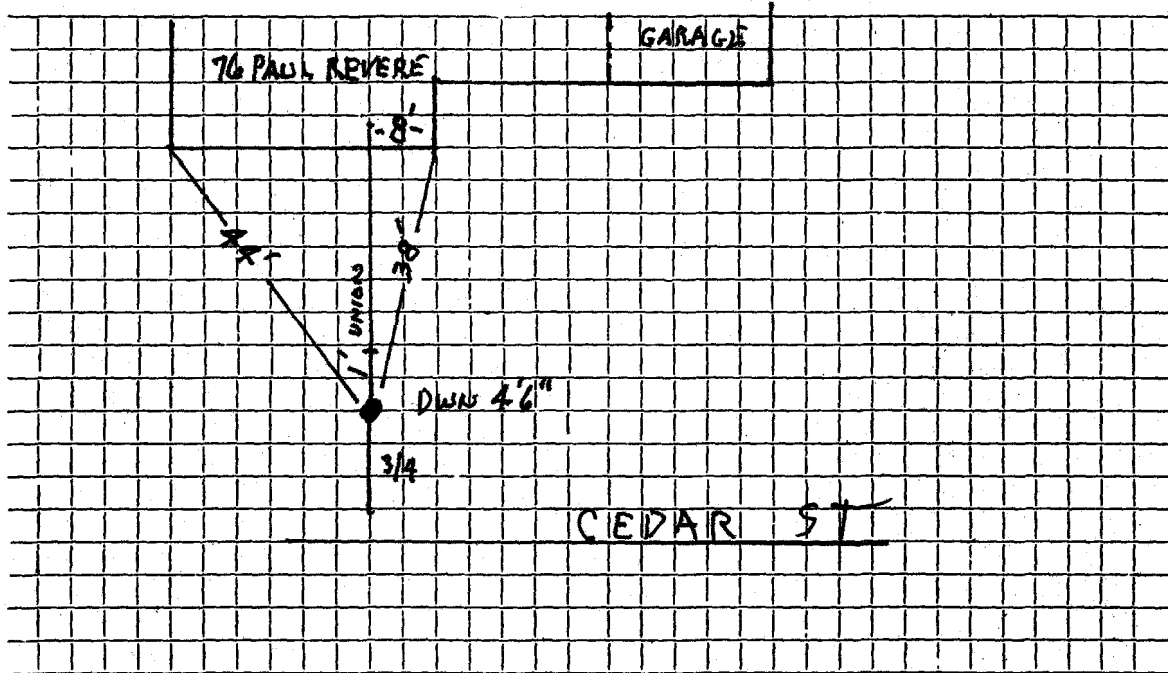

Connection made in CEDAR ST..... Street. Work completed

Remarks:
.....
.....