


DATE 2 NOVEMBER 1995

TOWN OF LEXINGTON — BOARD OF PUBLIC WORKS

WATER DIVISION

Sketch of Service Here

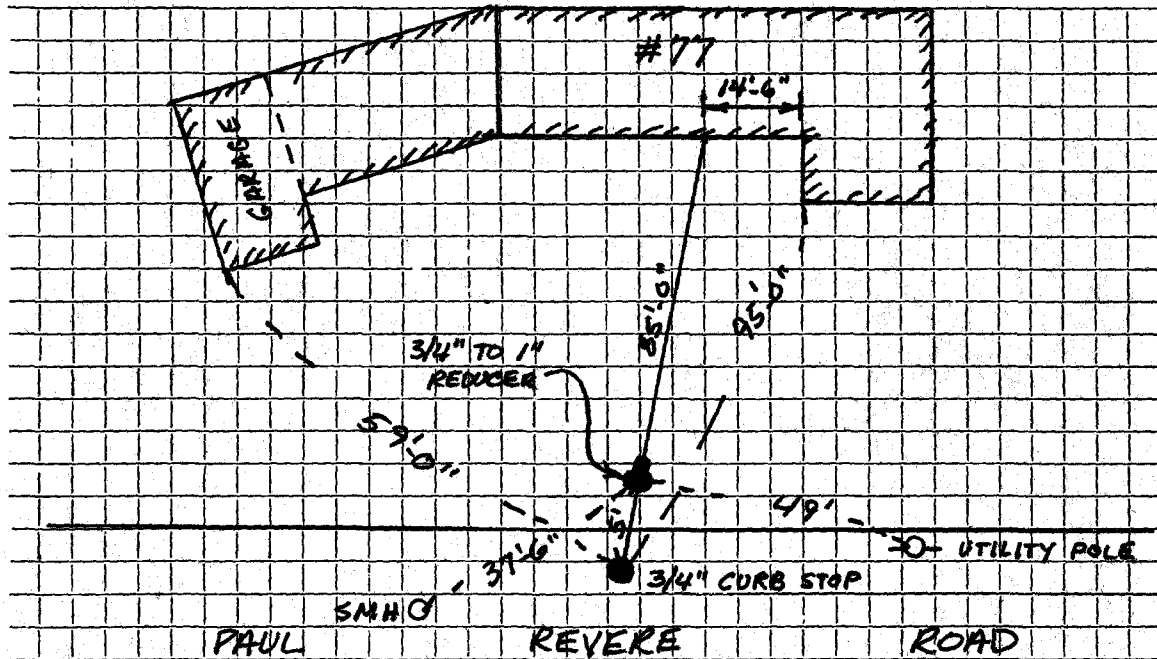

Connection made in PAUL REVERE ROAD Street.

Work completed J.M. MCLAUGHLIN, INC.

Remarks: