

WATER SERVICE RECORD

4491

Name DeVries Const. Co.

Service No.

289

Address 9 Paul Revere Road

Location Lexington

~~REPAIR WORK~~ - New Service


Conn. 11-24-52

Date	Material	Amount	Total	Date	Amount
10/27/52	Labor	7 53		10-29-52	65 -
	10% overhead	75	8 28	11-24-52	37
	66' - 3/4" copper tubing@.34		22 44	<i>Deposited</i>	
	1 -3/4" C x 1/2 I.W.H.stop& waste		4 00	<i>Returned & credited</i>	
	1 -3/4" C x 3/4" C.union		1 72	<i>to W.C.# 163</i>	
	1 hr. town shovel		5 00	<u>NON CHARGE</u>	
	1 hr. trucking		75	10/27/52	22 59
	patching 19 x 3		19 00	Labor	
			61 19	22' - 3/4" copper tubing@ .34	7 48
				1 -3/4" C. corp-cock	4 33
				1 -3/4" C x 3/4" C.curb-cock	4 67
				1 box and rod	3 90
				1 -1/2 offset tail piece	50
				1 -1/2 straight tail piece	50
				1 hr. town shovel	5 00
				1 hr. trucking	75
					<u>49 72</u>

DATE _____

TOWN OF LEXINGTON BOARD OF PUBLIC WORKS
WATER DIVISION

Sketch of Service Here

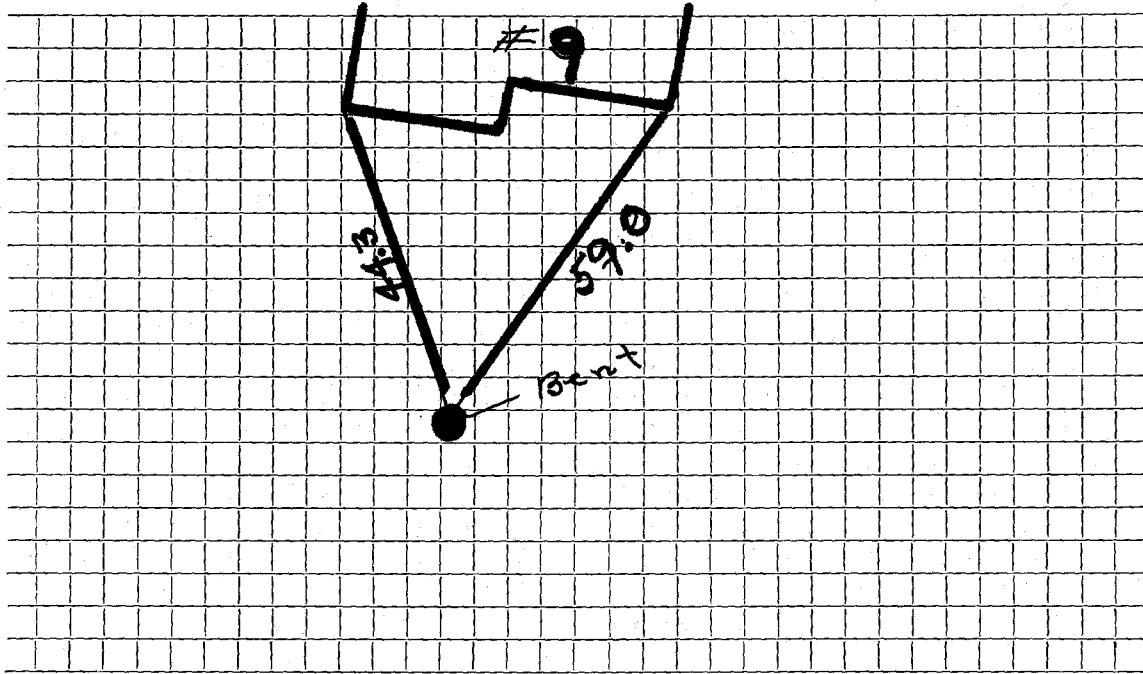

Connection made in Street. Work completed

Remarks:
.....
.....