




DATE 7-23-1999

TOWN OF LEXINGTON BOARD OF PUBLIC WORKS

WATER DIVISION

Sketch of Service Here

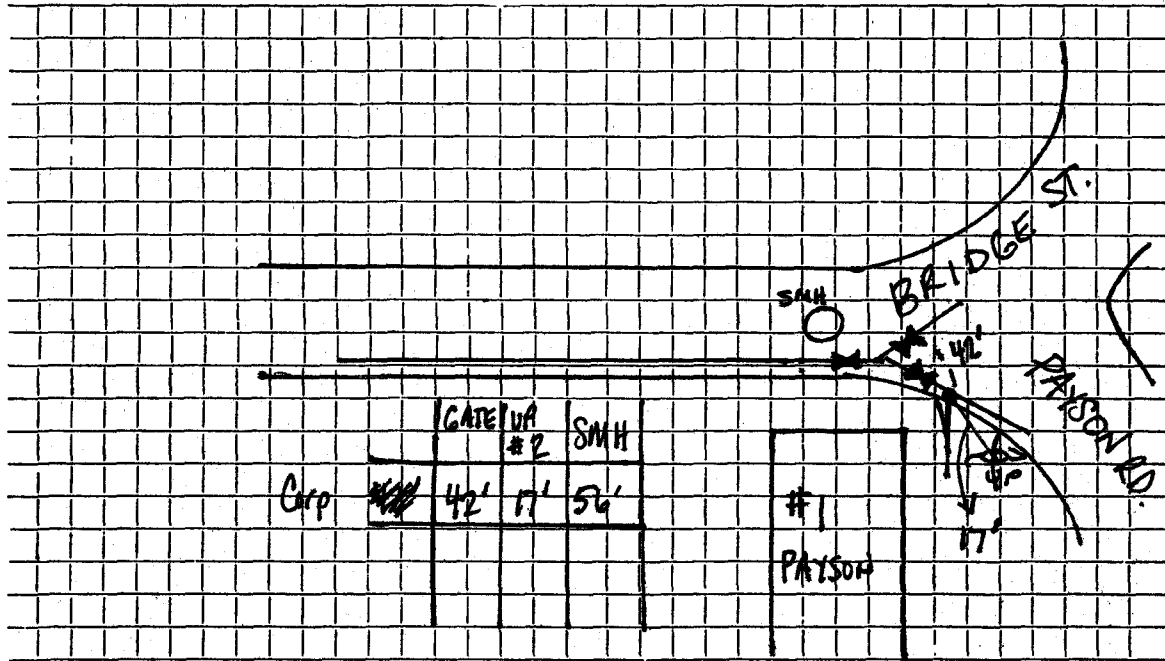

Connection made in 8" MAIN @ BRIDGE/PAYSON Int Street. Work completed NEW CORPORATION / Curb Stop: Box

Remarks: New Copper (1") to replace EXISTING LEAD SERVICE to Curb/Box.