




DATE 7-21-1999

TOWN OF LEXINGTON — BOARD OF PUBLIC WORKS  
WATER DIVISION

Sketch of Service Here

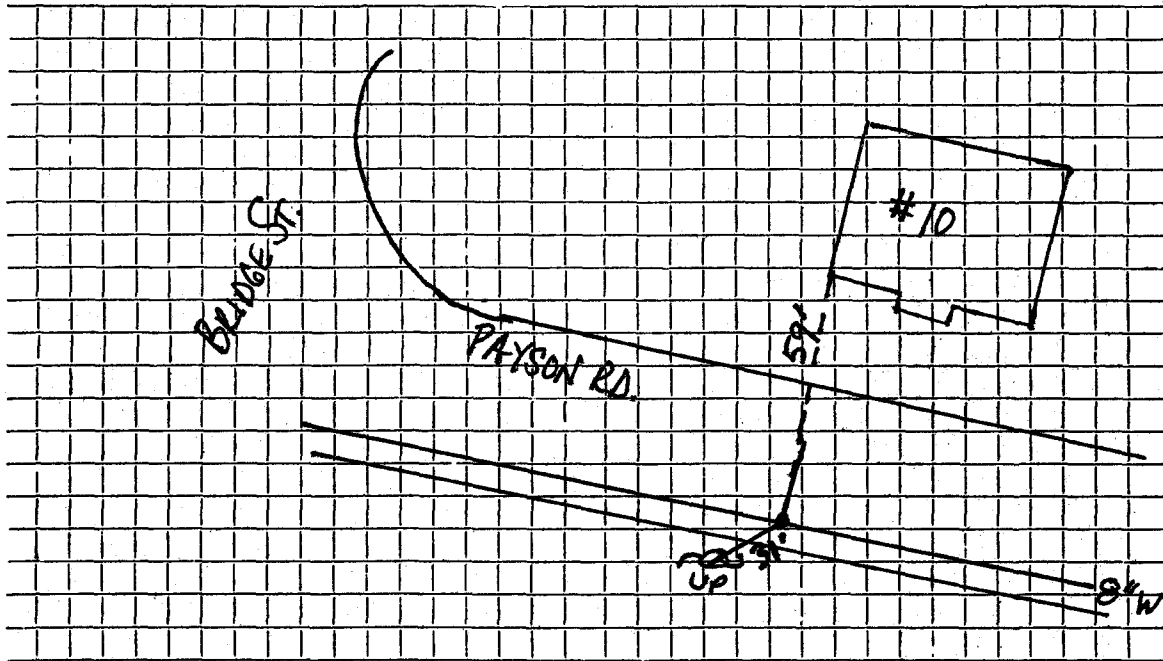

Connection made in 8" MAIN ON OPP. SIDE OF PAYSON RD. Street. Work completed NEW CORPORATION, UNION

Remarks: 3/4" SERVICE

Name Nathaniel A. Colbert

Service No. 149

Address 10 Payson Road

#5912

Location 10 Payson Road

Kind of Pipe

Size

Size of Main

~~REPAIR~~ ~~REPAIR~~ - New Service

Com. 9-19-49

Location

Date	Material	Amount	Total	Date	Amount
July 22, '49	Labor	3 55	3 55	July 19, '49	40 00
	10% Overhead		36	Sept 20, '49	8 45
	40' - 3/4" Copper Tubing @.24	9 60	9 60		<u>31 55</u>
	1 - 3/4" C x 1/2" I.W.H. S&W	3 29	3 29	July 23, '49	Labor
	Littlefield Shovel 2 hrs. @7.00	14 00	14 00		6 15
	Trucking 1 hr.		75		24' - 3/4" Copper Tubing @.24
			31 55		5 76
					1 - 3/4" C Corp-cock
					3 15
					1 - 3/4" C x 3/4" C Curb-cock
					3 85
					1 - Box & Rod
					3 95
					2 - 1/2" Straight Tail Pieces @.37
					74
					Littlefield Shovel 2 hrs. @7.00
					14 00
					Trucking 1 hr.
					75
					<u>38 35</u>
	Labor				

DATE \_\_\_\_\_

TOWN OF LEXINGTON - BOARD OF PUBLIC WORKS

**WATER DIVISION**

The undersigned applies for a supply of water at No..... St. and hereby agrees to comply with the rules and regulations as now, or at any future time, established by the Board of Selectmen.

Am't of Estimate \$.....

Owner .....


Am't Paid \$.....

Address .....

Builder .....

.....

**Sketch of Service Here**

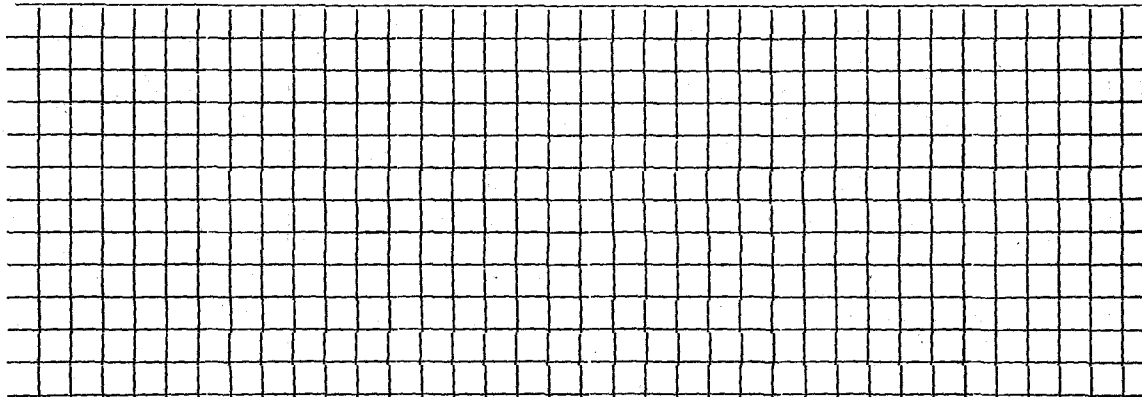

Connection made in ..... Street.

Work completed .....19

Remarks: