


DATE 7-22-1999

TOWN OF LEXINGTON — BOARD OF PUBLIC WORKS
WATER DIVISION

Sketch of Service Here

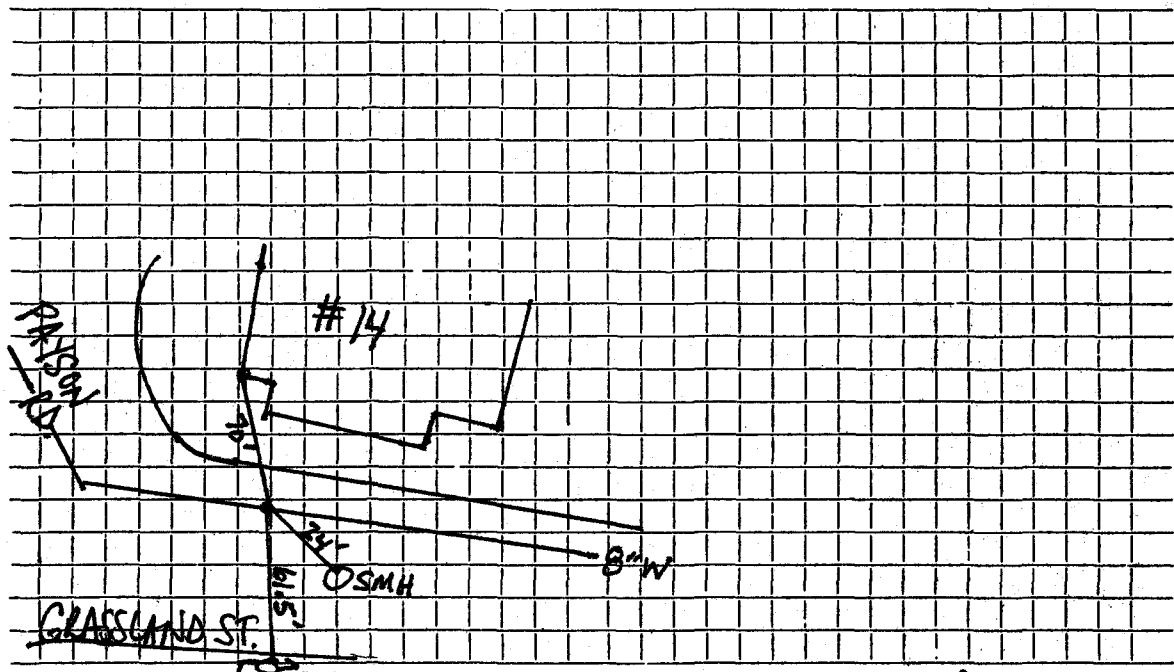

Connection made in 8" MAIN @ PAXSON/GRASSLAND INT Street.

Work completed New Corporation, Union


Remarks:

DATE 7-2-02

TOWN OF LEXINGTON — BOARD OF PUBLIC WORKS

WATER DIVISION

Sketch of Service Here

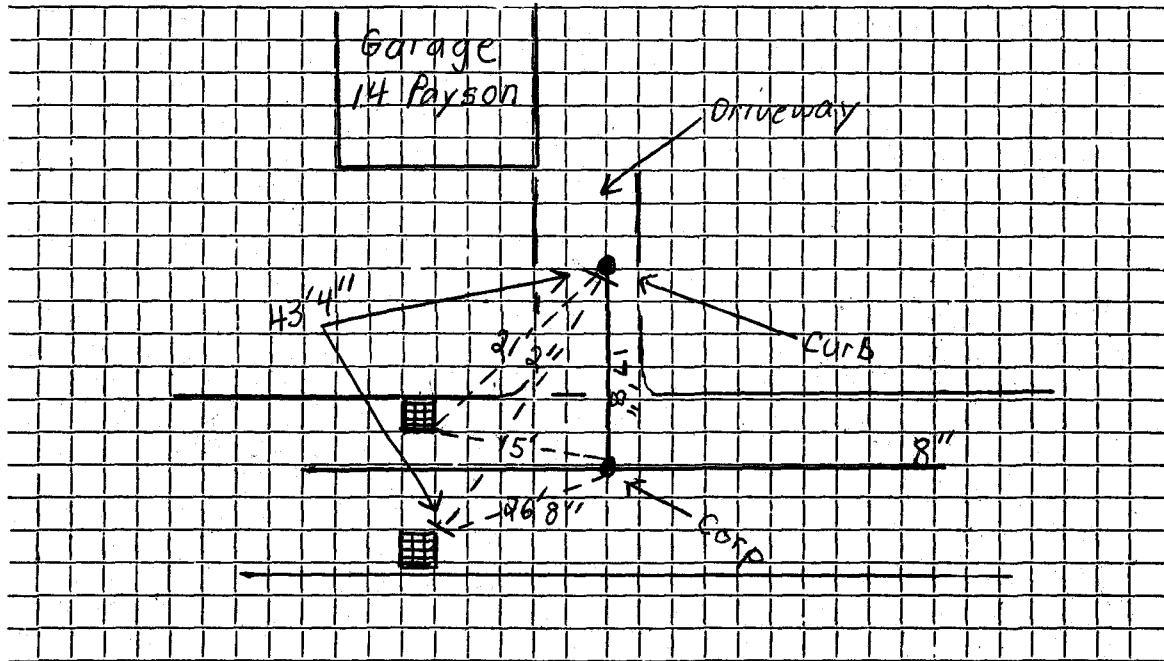

Connection made in Street. Work completed

Remarks:

.....

.....