

WATER SERVICE RECORD

Name

Service No.

Address #2 PAYSON RD

Location CORPORATION OFF 8" MAIN ON PAYSON


Repair Renewal New Service WATERMAIN CLEANING & LINING PROJECT C9902 : BISZKO Co.

Date	Material	Amount	Total	Date	Amount
				7-21-1999	
				3'	1" COPPER BTW CORPORATION & UNION
				1	CORPORATION
				1	UNION

DATE 7-21-1999

TOWN OF LEXINGTON — BOARD OF PUBLIC WORKS  
WATER DIVISION

Sketch of Service Here

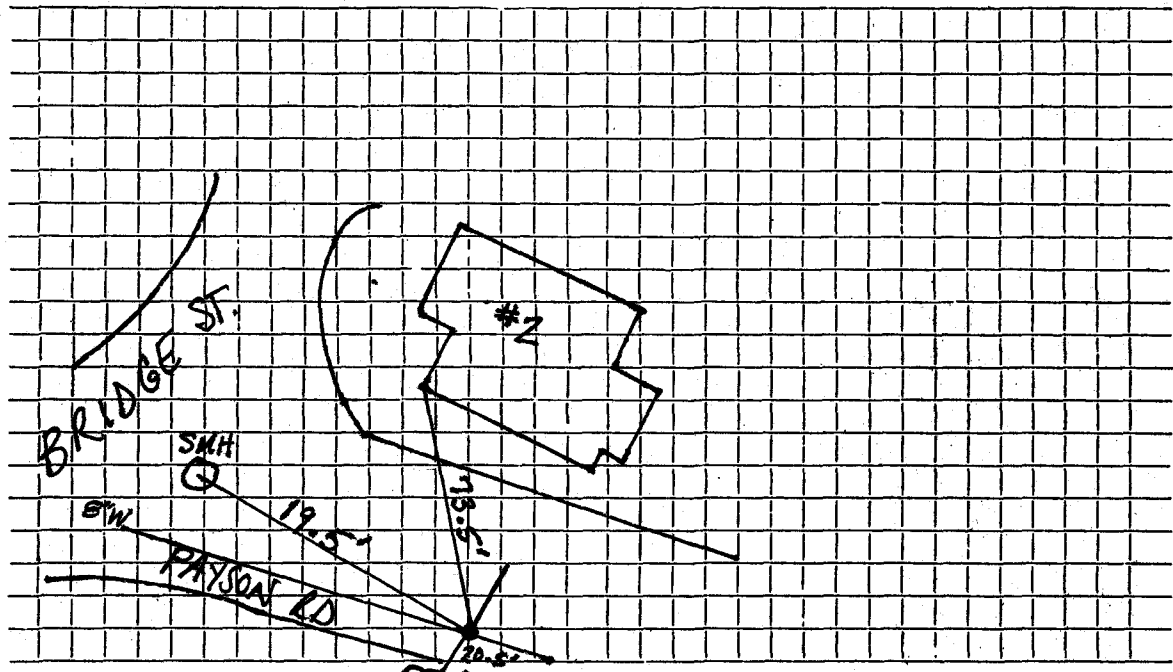

Connection made in 8" MAIN OPPOSITE OF PAYSON Street.

Work completed NEW CORPORATION, UNION

Remarks: 3/4" SERVICE TO HOUSE