

WATER SERVICE RECORD

Name John Belcik

Service No.

3125
#5008
248

Address 14 Payson ~~ROAD~~ ST

Location

~~Water Service~~ - New Service

Com. 11-8-54


Date	Material	Amount	Total	Date	Amount
10/16/54	Labor	12 82		10-4-54 Deposited	75 00
	10% overhead	1 28	14 10	11-8-54 Refunded	(21 55)
	56' - 3/4" copper tubing @ .35		19 60		<u>NON CHARGE</u>
	1 - 3/4" C x 1/2 I.W.H. stop & waste		4 00	10/16/54 Labor	12 83
	3 hrs. town shovel @ 5.00		15 00	26' - 3/4" copper tubing @ .35	9 10
	1 hr. trucking		75	1 - 3/4" C. corp-cock	4 33
			53 45	1 - 3/4" C curb-cock	4 67
				1 box and rod	3 90
				1 - 1/2 offset tail piece	50
				1 - 1/2 straight tail piece	50
				1 hr. town shovel	5 00
				1 hr. trucking	75
					<u>41 58</u>

DATE _____

TOWN OF LEXINGTON — BOARD OF PUBLIC WORKS

WATER DIVISION

Sketch of Service Here

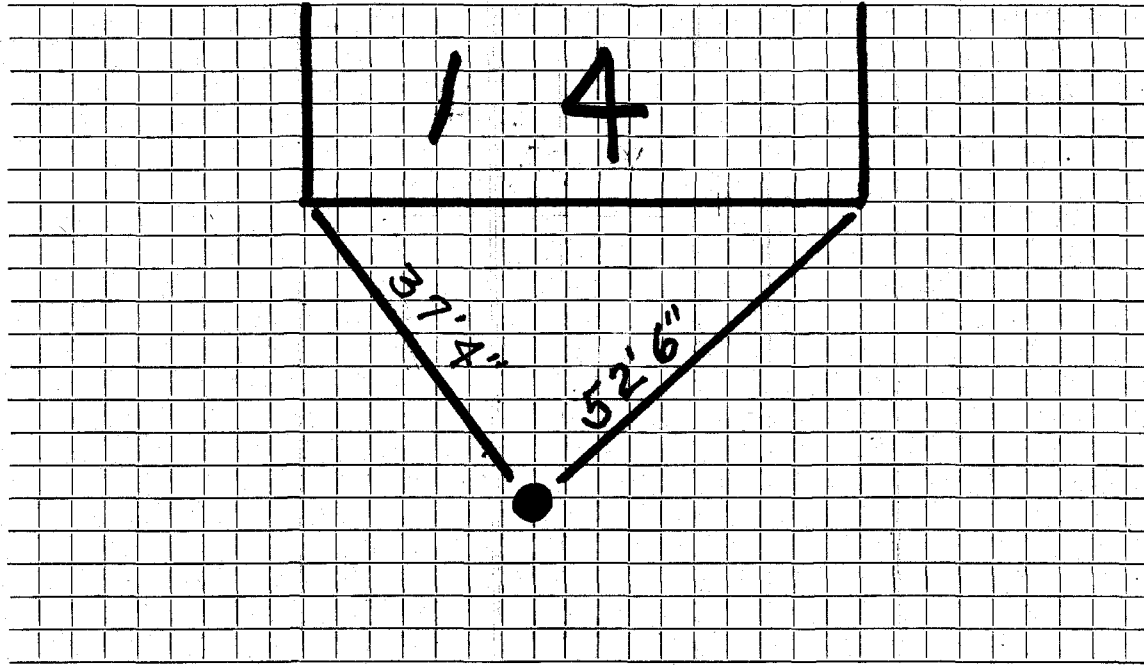

Connection made in Street. Work completed

Remarks:

.....

.....