
Name				Service No.			
Address 😯	Payson St						
Location	<u> </u>						
Repair Renewal New Service							
Date	Material	Amount	Total	Date		Amount	
11/17/20	I" type k						
	"type k copper pipe						
	1" curb stop						
	cambridgebrass						
	open right						
					,		

Date: 11/17/20

TOWN OF LEXINGTON - BOARD OF PUBLIC WORKS WATER DIVISON

SKETCH OF SERVICE HERE

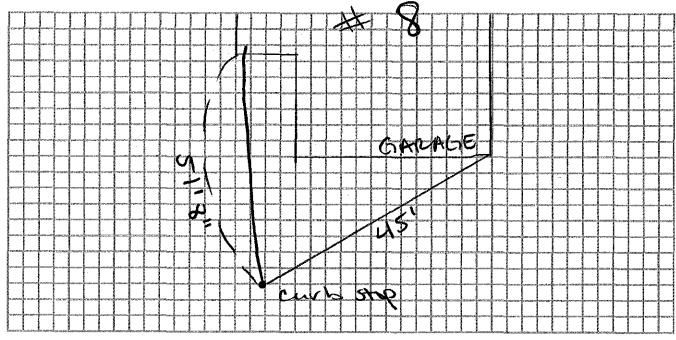

Connection made in:	Street.	Work completed:
Remarks:		