

WATER SERVICE RECORD.

#3642 #410

Name Edward P. Savage Jr.

Service No. 149

Address 1 Payson Street

Location

~~RENEWAL~~ Renewal ~~WORK ORDER~~ W.O. #8457

Comm 5-18-64


Date	Material	Amount	Total	Date	Amount	
1-3-64	Labor	51.74		12-3-63	Deposit	150.00
	10% O.H.	5.17	56.91	5-18-64	Return	47.50
36'	3/4" Copper tubing @.42		15.12			102.41
1	3/4" G x 1/2 I.W.H. Stop & Waste		6.17		NON CHARGE	
1	3/4" x 3/4" Copper to Iron Adapter		2.21	1-3-64	Labor	37.04
2	hrs. Town Shovel @6.50		13.00			
2	hrs. Trucking @3.00		6.00			
1	hr. Compressor		3.00			
			<u>102.41</u>			

DATE _____

TOWN OF LEXINGTON — BOARD OF PUBLIC WORKS

WATER DIVISION

Sketch of Service Here

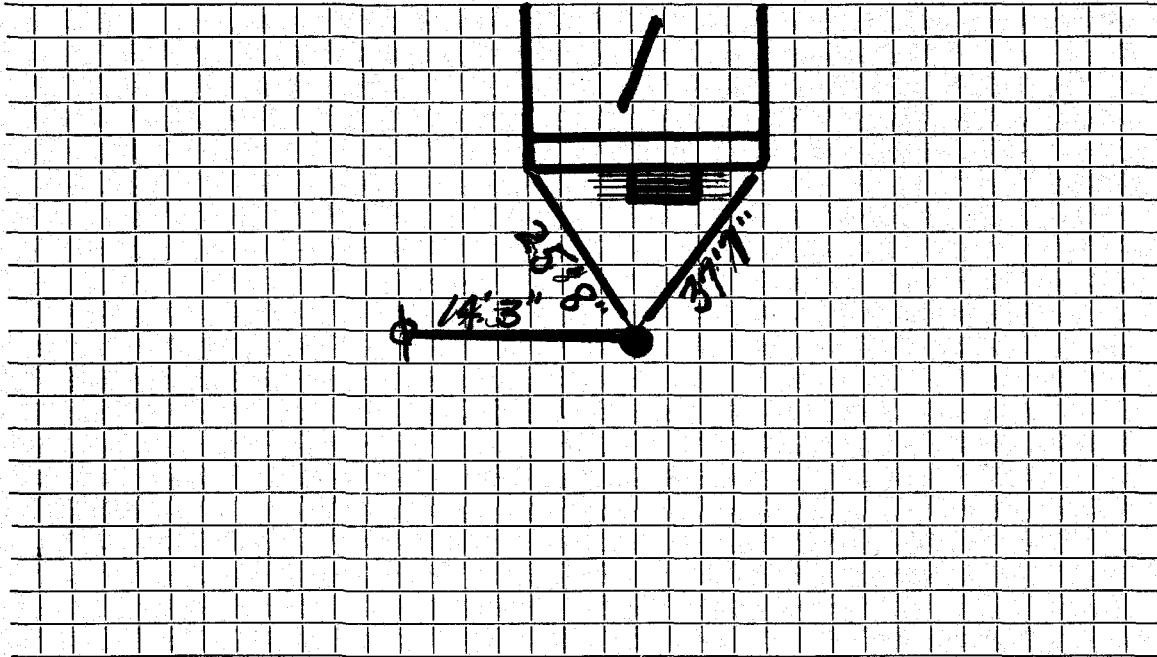

Connection made in Street. Work completed

Remarks:

.....

.....