

WATER SERVICE RECORD

#1945

Name Herbert Estabrook

Service No. 294

Address # 15 Peachtree Rd.

Location hot 6

~~Repair~~ - New Service


Comm 3-6-61

Date	Material	Amount	Total	Date	Amount
12-6-60	Labor	25.71		12-1-60	Deposit 100.00
	10% O.H.	2.57	28.28	3-6-61	Returned 24.35
	60% 3/4" Copper tubing @.42		25.20		75.65
	1 3/4" C x 1/2 I.W.H. Stop & Waste		6.17		NON CHARGE
	2 hrs. Town Shovel @6.50		13.00		1 1/2 Straight tailpiece .50
	1 hr. Trucking @3.00		3.00		1 1/2 Offset tailpiece .50
			75.65		1.00

TOWN OF LEXINGTON — BOARD OF PUBLIC WORKS

WATER DIVISION

Sketch of Service Here

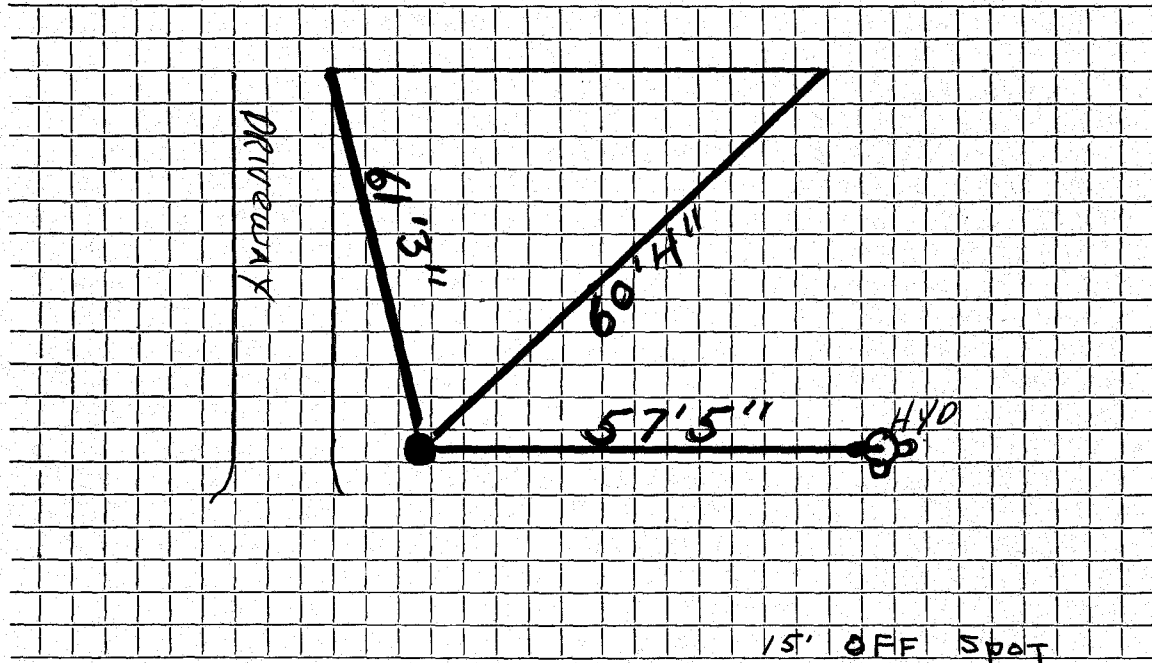

Connection made in Street. Work completed

Remarks:

.....

.....