

WATER SERVICE RECORD

Name John Lundquist

Service No. 160

Address 17 Peachtree Road

7214

Location

~~Water Connection~~ - New Service


Comm 9-19-60

Date	Material	Amount	Total	Date	Amount	
8-10-60	Labor	4.15		8-5-60	Deposit	50 00
	10% O.H.	.42	4.57	9-19-60	Refund	9 49
58'	3/4" Copper tubing @.42		24.36			40 51
1	3/4" C x 1/2 I.W.H. Stop & Waste		6.17		NON CHARGE	
1	3/4" C 3 part union		2.41	6/17/58	Labor	3 57
1	hr. Trucking @3.00		3.00	30'	3/4" Copper tubing @ .37	11 10
			40.51	1	3/4" C Corp Cock	4 64
				1	3/4" C Curb Cock	6 03
				1	Box & Rod	5 00
				1	Hour Trucking @ .75	75
						31 09
					1 1/2 Straight tailpiece	.50
					1 1/2 Offset tailpiece	.50
						32.09

DATE _____

TOWN OF LEXINGTON — BOARD OF PUBLIC WORKS
WATER DIVISION

Sketch of Service Here

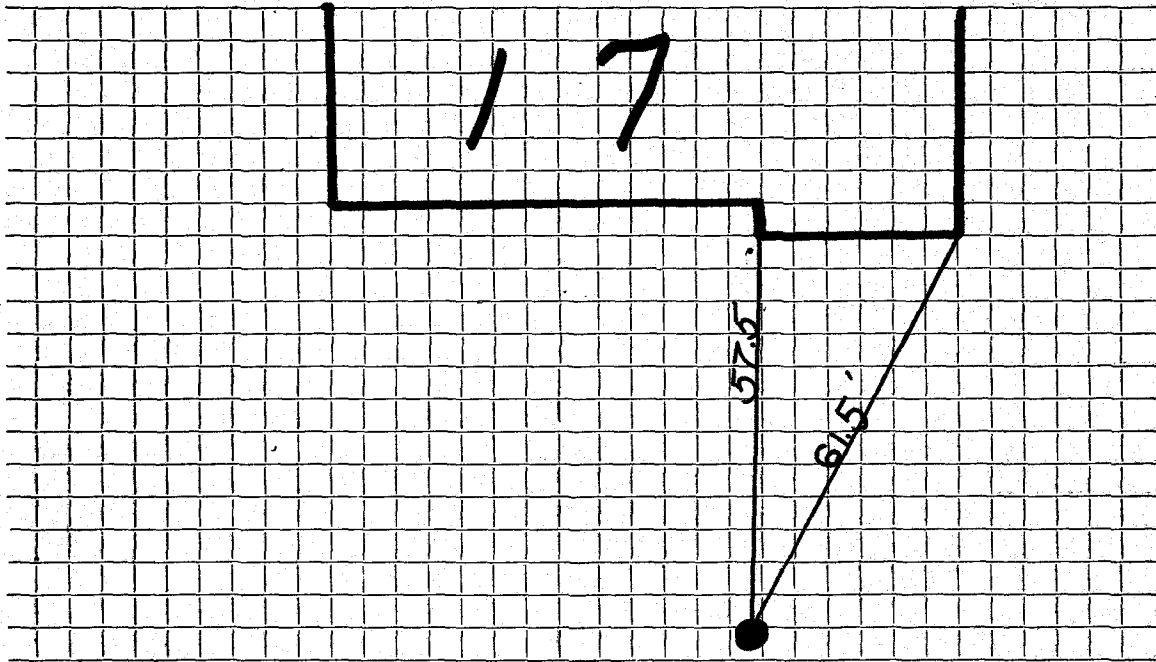

Connection made in Street. Work completed

Remarks:

.....

.....