

WATER SERVICE RECORD

4973

Name Outhet Realty Trust

Service No. 106

Address 18 Peach Tree Road

Location


~~REPAIR - REPAIR~~ - New Service

Conn 7-6-59

Date	Material	Amount	Total	Date	Amount	
6-3-59	Labor	1 77		6-1-59	Deposit	50 00
	10% O. H.	18		7-6-59	Refund	14 75
	66' 3/4" Copper Tubing @ .3666		24 20			35 08
	1 3/4" C x 1/2 IWH Stop & Waste		5 88		NON CHARGE	
	1 3/4" Copper 3 part Union		2 30	6/17/58	Labor	3 61
	1 Hr. Trucking @ .75		75		19' 3/4" Copper tubing @ .37	7 03
			35 08		1 3/4" C Curb Cock	6 03
					1 3/4" C Corp Cock	4 64
					1 Box & Rod	5 00
					1 Hour Trucking @ .75	75
						27 06
					1 1/2 Straight Tailpiece	50
					1 1/2 Offset Tailpiece	50
						28 06

TOWN OF LEXINGTON — BOARD OF PUBLIC WORKS
WATER DIVISION

Sketch of Service Here

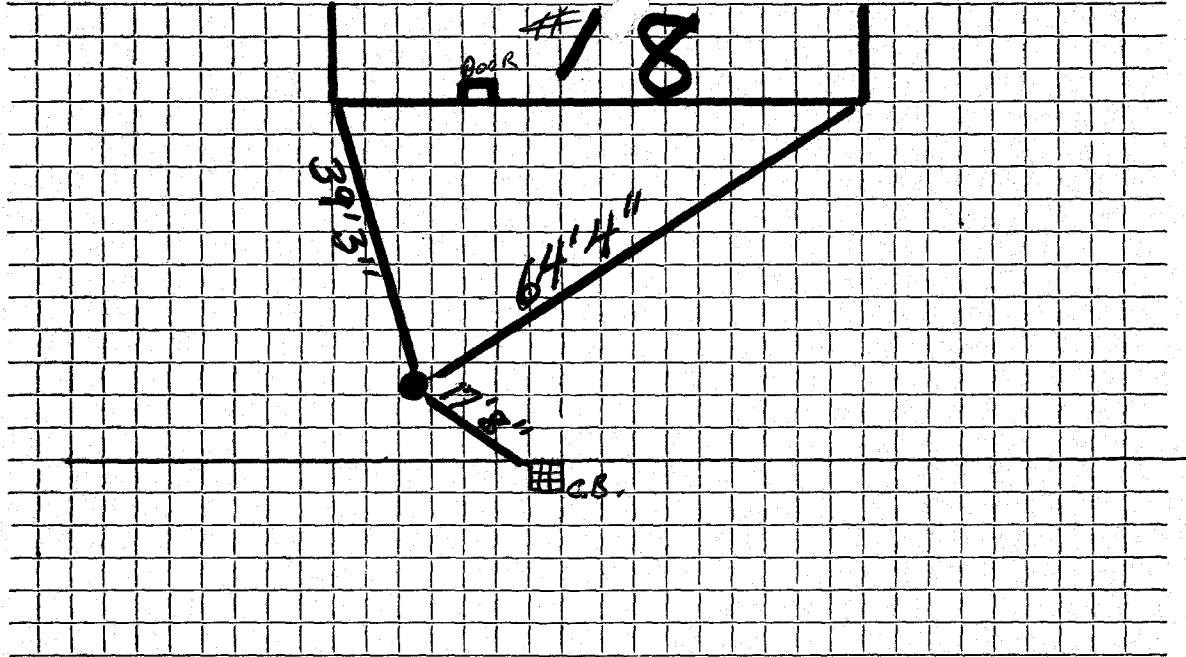

Connection made in Street. Work completed

Remarks:

.....
.....