

WATER SERVICE RECORD

4710

Name Harris Cohen

Service No. 97

Address 20 Peach tree Road

Location

~~Repair~~ ~~Renewal~~ ~~New Service~~ Kirkland & Shaw Permit #1


061 25 1905

Date	Material	Amount	Total	Date	Amount
9-24-65	35' 1" Copper tubing			9-25-65	Deposit 25 91
					NON CHARGE
				6/17/58	Labor 3 57
					16' 3/4" Copper tubing @ .37 5 92
					1 3/4" C Corp Cock 4 64
					1 3/4" C Curb Cock 6 03
					1 Box & Rod 5 00
					1 Hour Trucking @ .75 75
					<u>25 91</u>

TOWN OF LEXINGTON — BOARD OF PUBLIC WORKS

WATER DIVISION

Sketch of Service Here

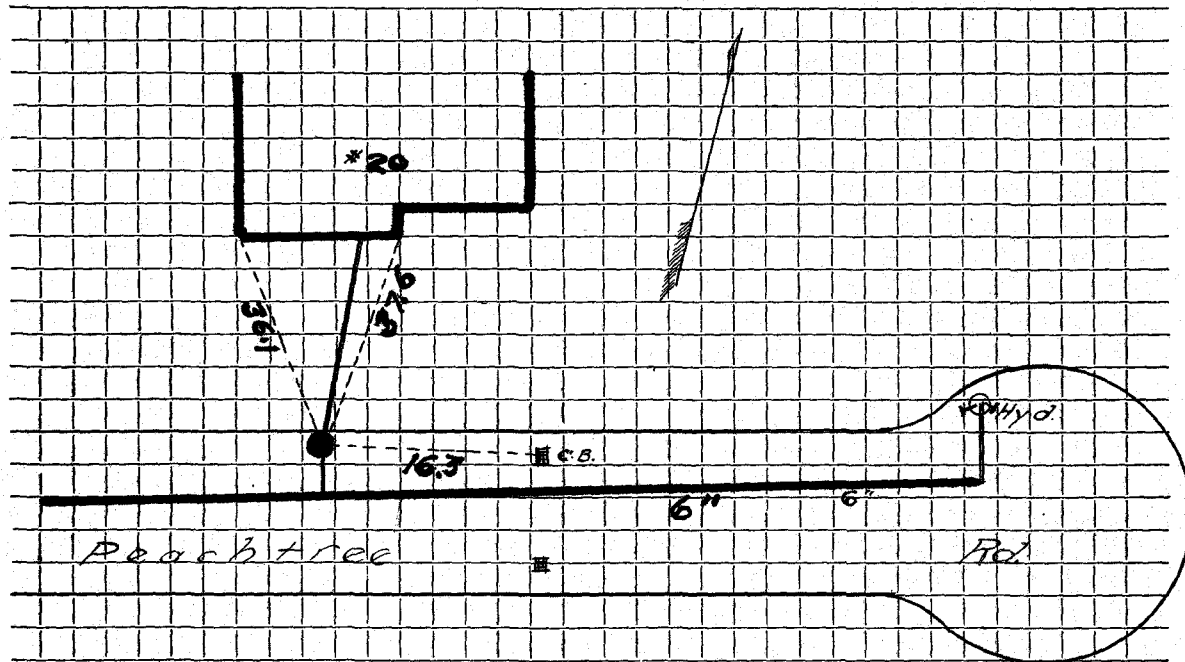

Connection made in Street. Work completed

Remarks:

.....

.....