

WATER SERVICE RECORD

Name Stephen Stavro

Service No. 260  
(1958)

Address 21 Peachtree Road

Location

~~Repair~~ ~~Work~~ New Service


Comm 6-1-59

Date	Material	Amount	Total	Date	Amount
4-21-59	Labor	6.21		11-17-58	50.00
	10% O.H.	.61	6.73	6-1-59	6.14
	75' 3/4" Copper tubing @ .3666		27.50		43.84
	1 3/4" C x 3/4" I.W.H. Stop & Waste		<del>5.00</del>		
	1 3/4" C 3 part union		2.27	6/17/58	3.57
	1 hr. Trucking @ .75		.75	26' 3/4" Copper tubing @ .37	9.62
			<del>43.84</del>	1 3/4" C Corp Cock	4.64
6-14-61	Repair		43.84	1 3/4" C Curb Cock	6.03
	1 3/4" X 3/4" Comp Valve			1 Box & Rod	5.00
				1 Hour Trucking @ .75	75
					29.61
				1 3/4" Straight tailpiece	.50
				1 3/4" Offset tailpiece	.50
					30.61

DATE \_\_\_\_\_

TOWN OF LEXINGTON — BOARD OF PUBLIC WORKS  
WATER DIVISION

Sketch of Service Here

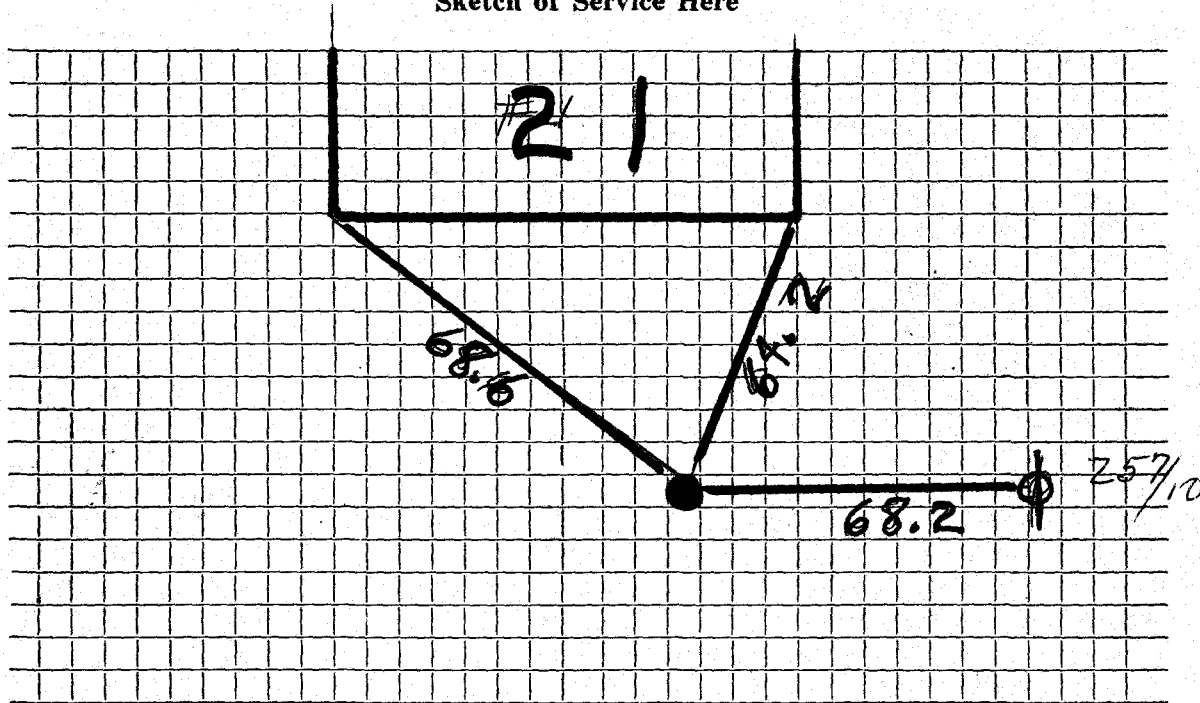

Connection made in ..... Street. Work completed .....

Remarks: .....  
.....  
.....