

WATER SERVICE RECORD

Name Justin Margolskee

Service No. 287

Address 23 Peach Tree Road

6976

Location

~~Repair~~ New Service


Comm. 12-31-60

Date	Material	Amount	Total	Date	Amount
12-28-60	Labor	22 73		11-25-60	Deposit 50 00
	10% Overhead	2 27	25 00	1-12-61	Paid 31 02
87'	3/4" Copper tubing @42		36 54		81 02
1	3/4" Cx 1/2 I.W.H. Stop&Waste		6 17		NON CHARGE
1	3/4" C3 part Union		2 41	6/17/58	Labor 33 57
1	Box & Rod		4 90	77'	3/4" Copper tubing @ /37 28 49
1	Hr. Trucking @3.00		3 00	1	3/4" C Corp Cock 4 64
1	Hr. Compressor @3.00		3 00	1	Box & Rod 5 00
			81 02	1	3/4" C Cub Cock 6 03
				1	Hour Trucking @ .75 75
					48 58
					1 1/2 Straight tailpiece 50
					1 1/2 Offset tailpiece 50
					49 48
				11-31-60	Bill sent 31.02

TOWN OF LEXINGTON — BOARD OF PUBLIC WORKS

WATER DIVISION

Sketch of Service Here

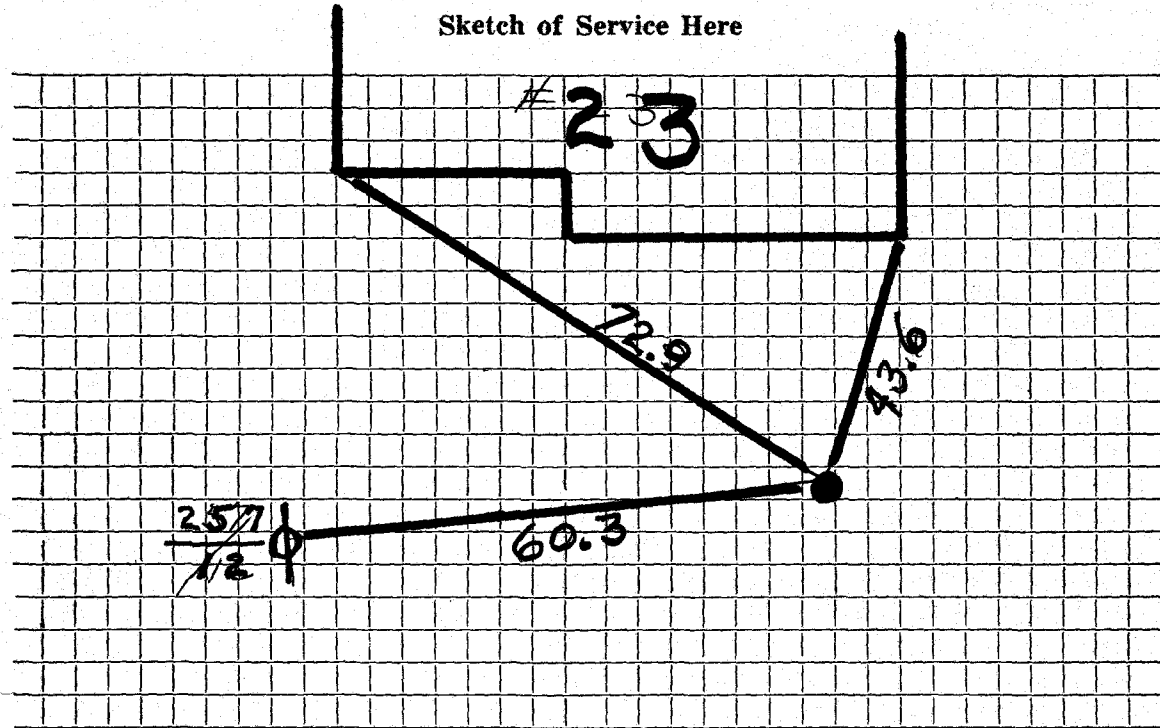

Connection made in Street. Work completed

Remarks:
.....
.....