

WATER SERVICE RECORD

Name Outhet Realty Trust

Service No. 127

Address 24 Peachtree Road

Location

~~Repair - REPAIR~~ - New Service


Comm 7-6-59

Date	Material	Amount	Total	Date	Amount	
6-18-59	Labor	2 14		6-16-59	Deposit	175 00
	10% O. H.	21	2 35	7-6-59	Returned	32 56
	85' 3/4" Copper Tubing @ .3666	31 16				42 44
1	3/4" C x 1/2 IWH Stop & Waste	5 88			NON CHARGE	
1	3/4" C 3 part Union	2 30		6/17/58	Labor	3 57
1	Hr. Trucking @ .75	75		72' 3/4" C	Copper tubing @ .37	26 64
			42 44	1 3/4" C	Corp Cock	4 64
				1 3/4" C	Curb Cock	6 03
				1 Box & Rod		5 00
				1 3/4" C	Union 3 part	2 27
				1 Hour	Trucking @ .75	75
						48 90
					1 3/4" Straight Tailpiece	50
					1 3/4" Offset Tailpiece	50
						49 90

TOWN OF LEXINGTON — BOARD OF PUBLIC WORKS

WATER DIVISION

Sketch of Service Here

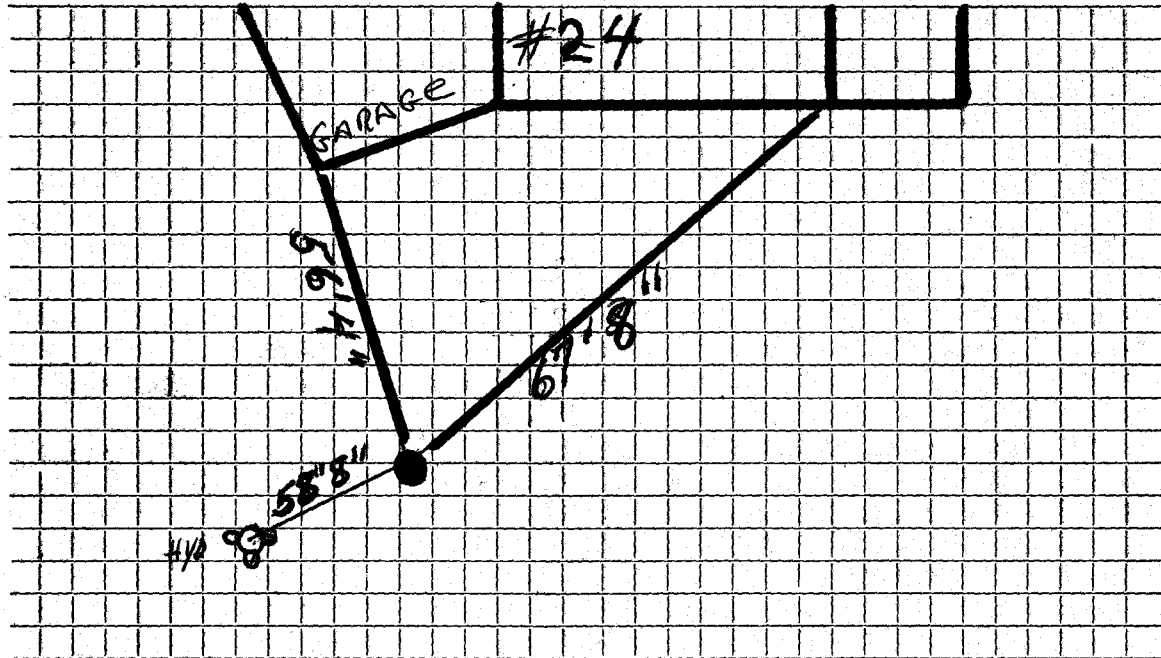

Connection made in Street. Work completed

Remarks:

.....

.....