




DATE 2/5/12

TOWN OF LEXINGTON — BOARD OF PUBLIC WORKS

WATER DIVISION

Sketch of Service Here

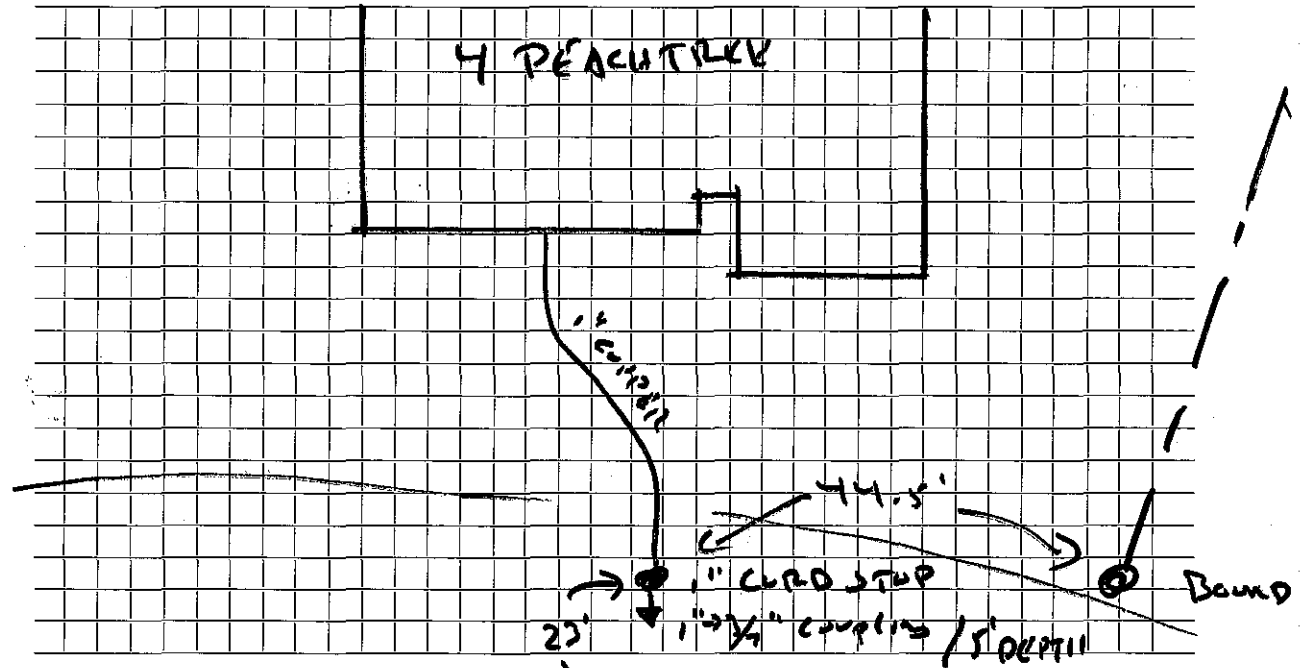

Connection made in PEACHTREE Street. 305m Work completed MALDEN

Remarks: