

WATER SERVICE RECORD

Name Marissa Liggiero (Insp.)

Service No.

Address 4 Peachtree

Location

Contractor: JM McLaughlin

Repair—Renewal—New Service


Date	Material	Amount	Total	Date	Amount
3/2018	HOME to CURB				
	1" Copper Pipe	58'			
	1" Curb Stop				
	open risant				
	amb. brass				
	Type K				

DATE 3/2018

TOWN OF LEXINGTON — BOARD OF PUBLIC WORKS
WATER DIVISION

Sketch of Service Here

4

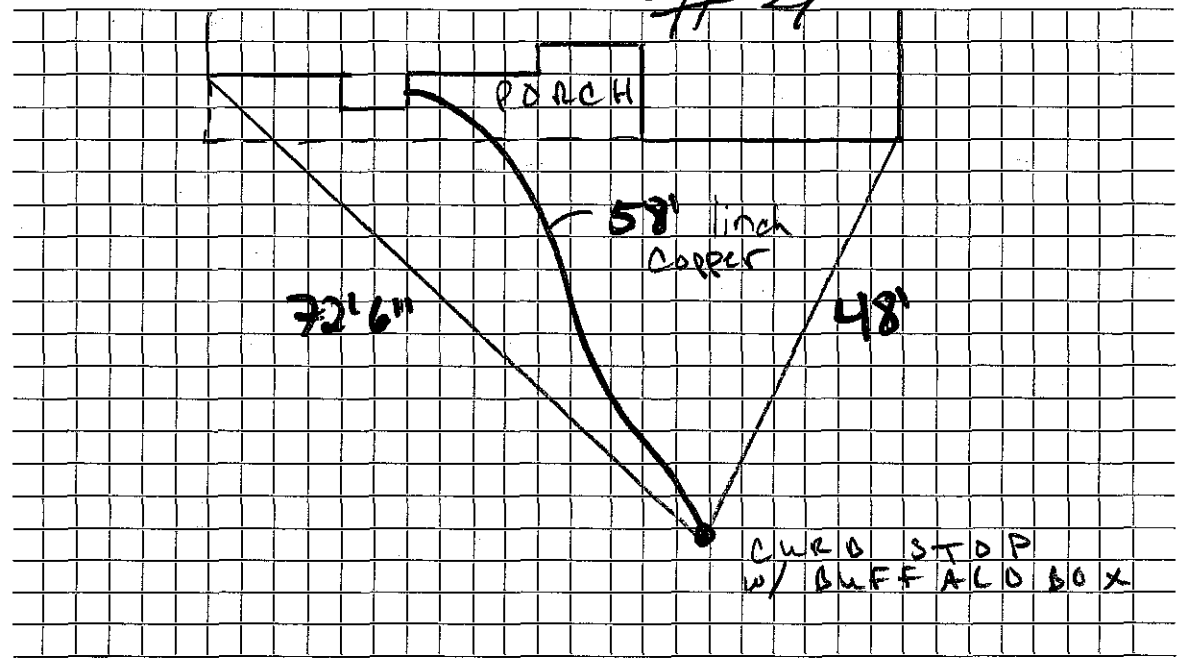

Connection made in Peachtree Street. Work completed

Remarks: taken from JM McLaughlin's tier