

WATER SERVICE RECORD

Name Kelly Corp.

Service No. 264

Address 6 Peachtree Road

Location Lexington

~~REPAIR WORK~~ - New Service

Conn. 12-1-52


Date	Material	Amount	Total	Date	Amount
10/29/52	Labor	1 63		10-9-52	Deposited 10 -
	10% overhead	16	1 79	12-1-52	Refunded (3 46)
	1 -3/4"Cx 1/8 I.W.H. stop& waste		4 00		NON CHARGE 4 54
	1 hr. trucking		75	10/29/52	Labor 3 15
			6 54	10' - 3/4" copper tubing@.34	3 40
	TRENCH DUG BY OWNER			1 -3/4" c. corp-cock	4 33
	PIPE SUPPLIED AND LAID BY OWNER			1 - 3/4"C x 3/4"C. curb-cock	4 67
				1 box and rod	3 90
				1 -1/8 straight tail pc.	50
				1 -1/8 offset tail pc.	50
				1 hr. trucking	75
					<u>21 20</u>

DATE _____

TOWN OF LEXINGTON — BOARD OF PUBLIC WORKS

WATER DIVISION

Sketch of Service Here

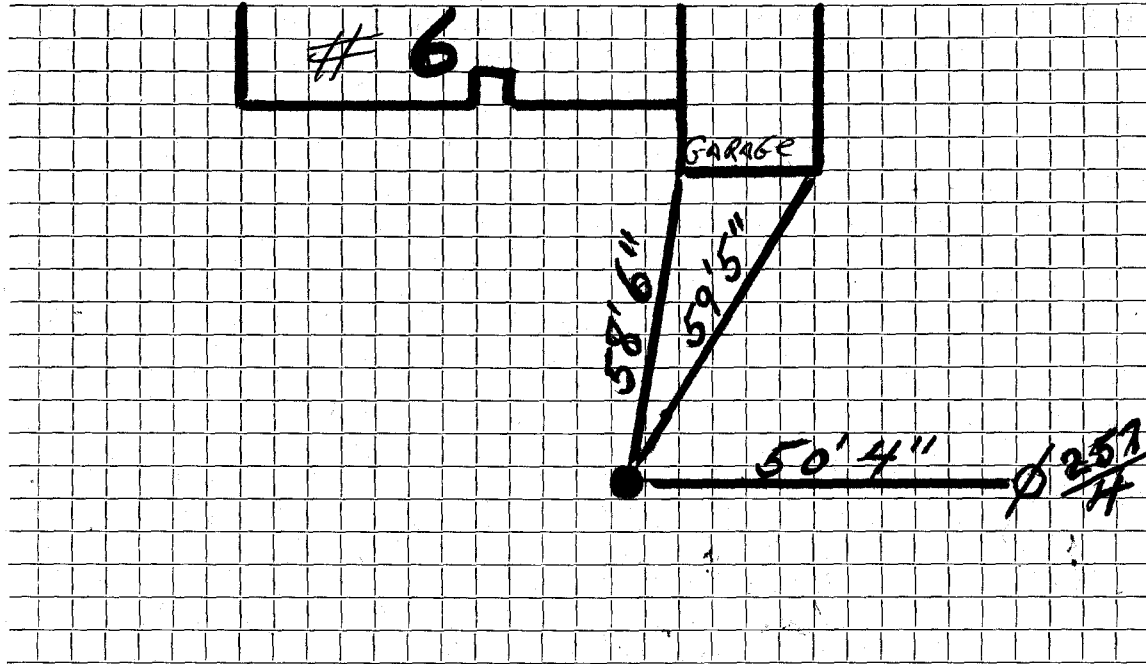

Connection made in Street. Work completed

Remarks:

.....
.....