


Water Service Tie Card  
**TOWN OF LEXINGTON**  
 MASSACHUSETTS

**9 Peachtree Rd**

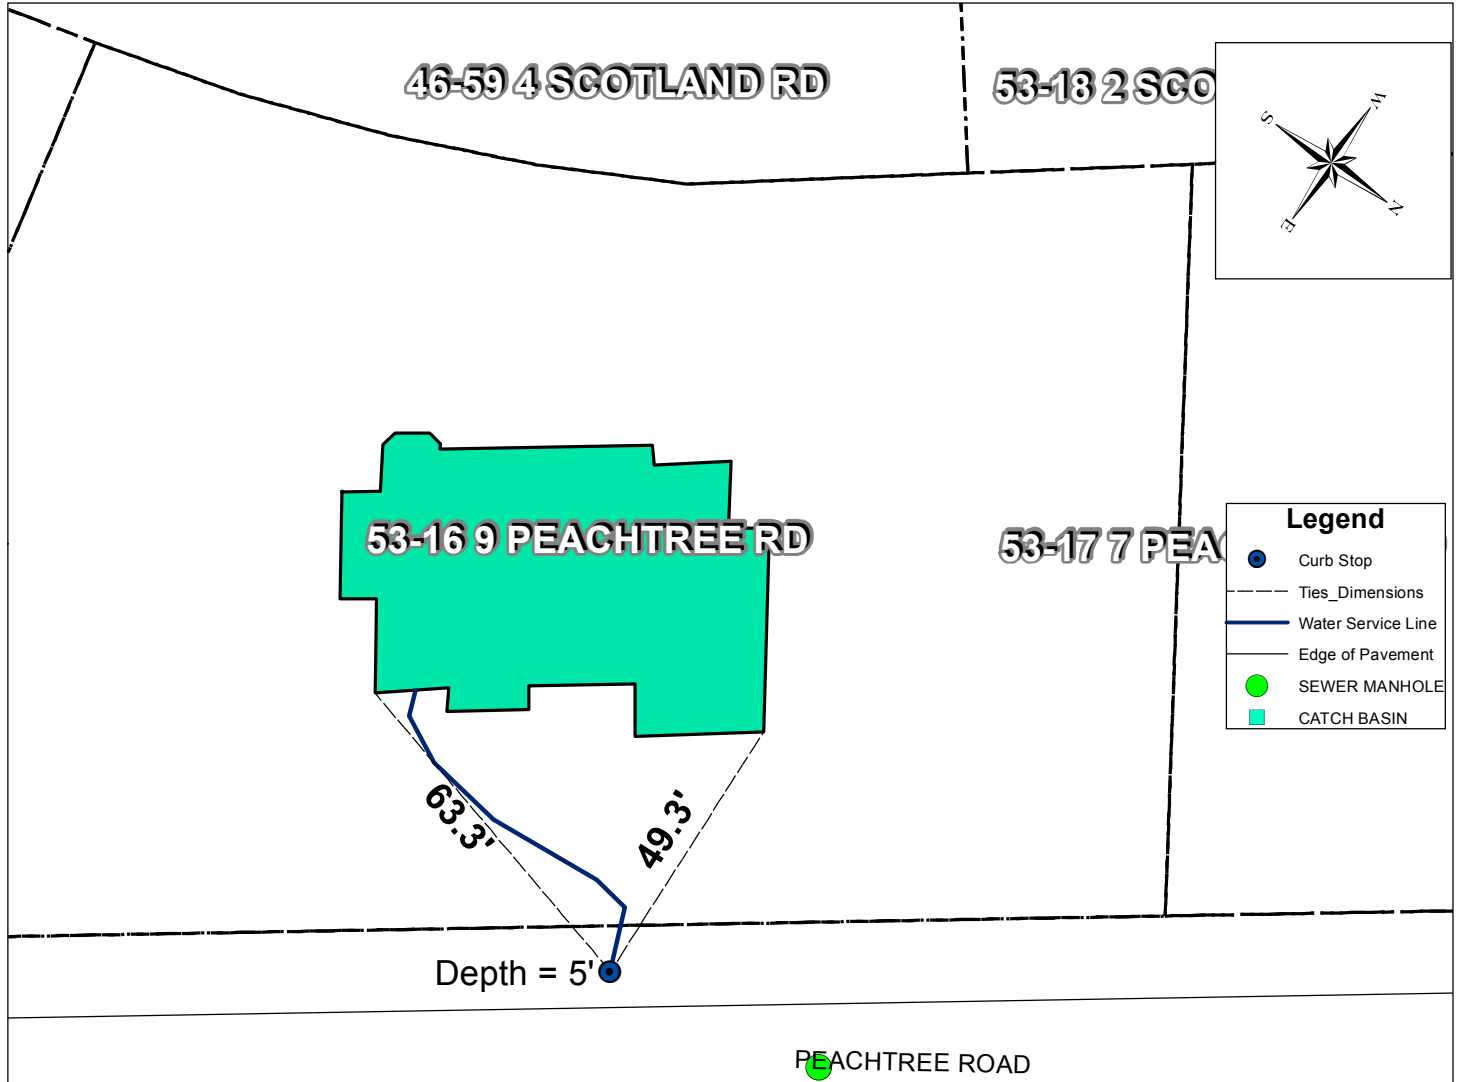

Address	Map and Lot	Permit Number	Contractor Name	Inspector
9 Peachtree Ln	53-16	5805	McLaughlin, James M. Inc.	dpavlik
Date	Material	Depth of Cover	Amount	
4/28/2015	3/4" Copper type "k"	5 ft	0.5 ft	
	3/4" to 1" fitting	5 ft	1	
	1" Copper type "k"	5 ft	0.5 ft	
	1" Curb Valve and Buffalo Box	5 ft	1	
	1" Copper type "k"	5 ft	70 ft	
Type of work completed				

New 1" water service to house from curb stop. New house on lot old house removed.