

WATER SERVICE RECORD

3629

Name L. A. Comeau

Service No. 153

Address 10 Peacock Farm Road

Location Lot 6

~~REPAIRS~~ - New Service

Com. 9-13-54


Date	Material	Amount	Total	Date	Amount
8/14/54	Labor	7 70		7-1-54	Deposited 25 00
	10% overhead	77	8 47	10-4-54	Paid 4 44
	70' - 3/4" copper tubing @ .35		24 50		NON CHARGE 39 44
	1 - 3/4"C x 1/2 I.W.H. stop & waste		4 00		SERVICE WAS IN TO CURB:
	1 - 3/4"C x 3/4"C. union		1 72	1 - 1/2 straight tail piece	50
	1 hr. trucking		75	1 - 1/2 offset tail piece	50
			39 44		1 00
	TRENCH DUG BY OWNER:			11-18-53	Labor 5.92
					10' 3/4" Copper tubing @3629 3.63
					1 3/4" G Corp Cook 4.33
					1 3/4" G Corp Cook 4.67
					1 box & rod 3.90
					1 hr. Trucking 75
					26.20

DATE _____

TOWN OF LEXINGTON — BOARD OF PUBLIC WORKS

WATER DIVISION

Sketch of Service Here

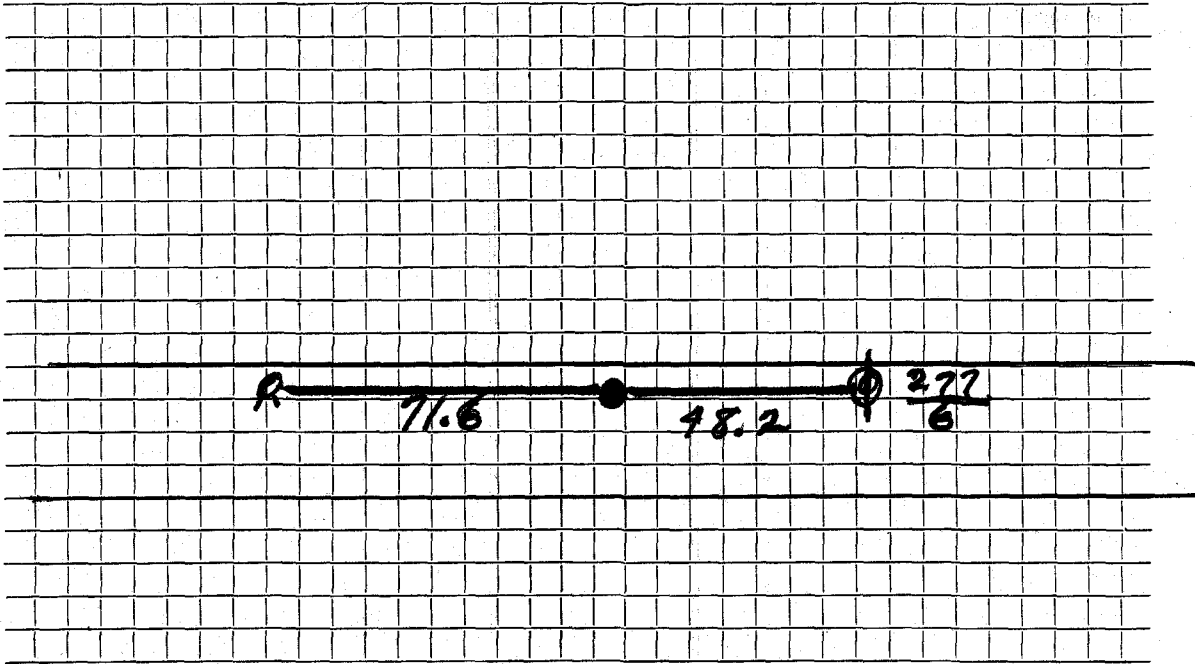

Connection made in Street. Work completed

Remarks:

.....

.....