

## WATER SERVICE RECORD

Name Benjamin Franklin Homes, Inc.

Service No. 401

Address 12 Peacock Farm Road

Location Lot #8

~~Repair~~ ~~Renewal~~ - New Service

Comm. 2-20-56


Date	Material	Amount	Total	Date	Amount
12-14-55	Labor	5 05		12-13-55	Deposited \$ 50 00
	10% overhead	51	5 56	2-20-56	Refund 2 00
	70' 3/4" copper tubing @ .4995	34 96			NON-CHARGE \$ 48 00
	1-3/4" x 1/2" I.W.H. Stop & Waste	4 96		12-14-55	Service was in
	1-3/4" Union (3 parts)	1 77			1-1/2" straight tailpiece 50
	1 hr. trucking	75			1-1/2" offset tailpiece 50
			48 00		1 00
				11-12-53	Labor 6.74
					11' 3.4" Copper tubing @ .3629 3.99
					1 3/4" G xorp cock 4.33
					1 3/4" G x 3/4" G curb cock 4.67
					1 box & rod 3.90
					1 hr. Trucking .75
					25.38

DATE \_\_\_\_\_

# TOWN OF LEXINGTON — BOARD OF PUBLIC WORKS

## WATER DIVISION

Sketch of Service Here

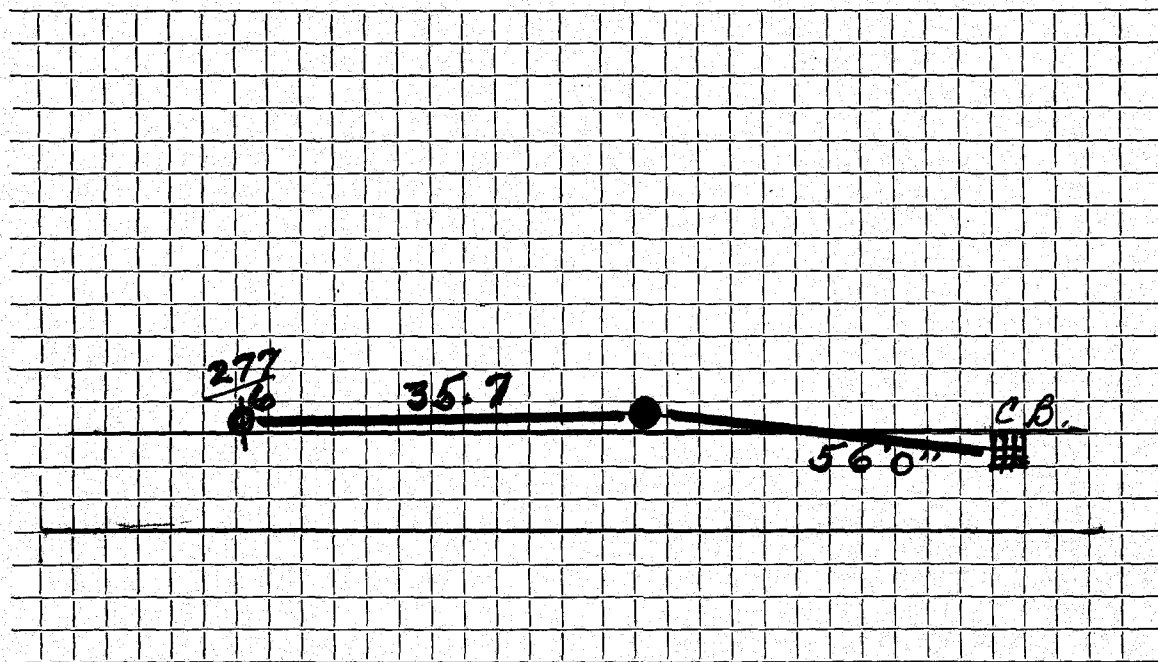

Connection made in ..... Street.      Work completed .....

Remarks: .....  
.....  
.....