

WATER SERVICE RECORD

Name

Service No.

Address 15 Peacock Farm Road


Location

Repair—~~REPAIR WORK SERVICE~~

Date	Material	Amount	Total	Date	Material	Amount	Total
1-5-56	60' 3/4" Copper			11-18-53	25' 3/4" Copper		
	1 3/4" C X 1/2" I.W.H.				1 3/4" C. Corp Cock		
		STOP + Waste			1 3/4" C. X 1/2" Curb Cock		
					1 Box + Rod		
					Non-charge		
				4-15-62	Labor		5.03
					8' 3/4" Copper tubing @ .42		3.36
					1 3/4" C Curb Cock @		6.28
					2 3/4" Style 88 Coupling		
					@ 2.90		5.80
					1 Hr. Trucking @ .75		.75
							21.22
					(Broken by contractor)		

TOWN OF LEXINGTON — BOARD OF PUBLIC WORKS
WATER DIVISION

Sketch of Service Here

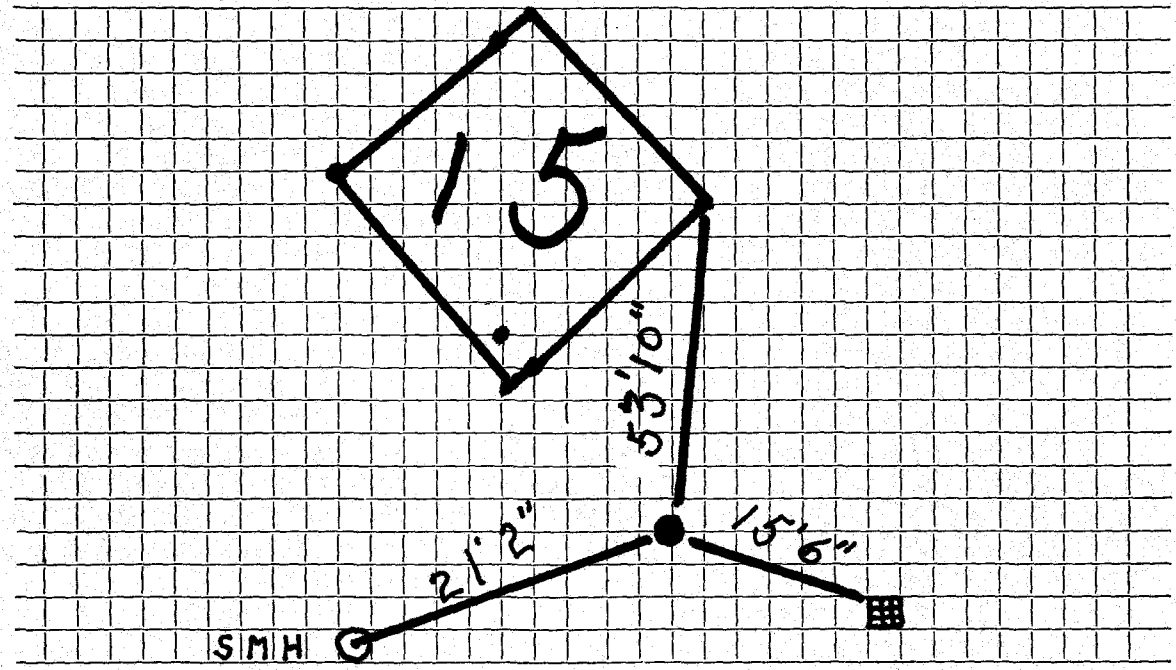

Connection made in Street. Work completed

Remarks:
.....
.....