

WATER SERVICE RECORD

Name **Benj. Franklin Homes Inc.**

Service No. **138**

Address **2 Peacock Farm Road**

Location

~~Repair - Ben Franklin~~ **New Service**


Comm. 10-8-56

Date	Material	Amount	Total	Date	Amount	
6/29/56	Labor	13 20		6-6-56	Deposit	150 00
	10% Overhead	1 32	14 52	10-8-56	Return	59 62
	75' 3/4" Coppertubing@ .4850		36 38		NON CHARGE	70 38
	1 3/4" I.W.H. Stop & Waste		4 96		Labor	7 60
	1 3/4" Union 3 part		2 27		10' 3/4" Coppertubing@.4850	4 85
	6x3 Patch		6 00		1 3/4" C.Corp Cock	4 64
	3 hrs. Littlefield @ 8.50		25 50		1 3/4" C.Curb "	5 94
	1 hr. trucking		75		1 Box & Rod	4 62
			90 38		1 Straight Tail Piece	50
					1 Offset " "	50
					1 hr. Littlefield @ 8.50	8 50
						37 15

DATE _____

TOWN OF LEXINGTON — BOARD OF PUBLIC WORKS
WATER DIVISION

Sketch of Service Here

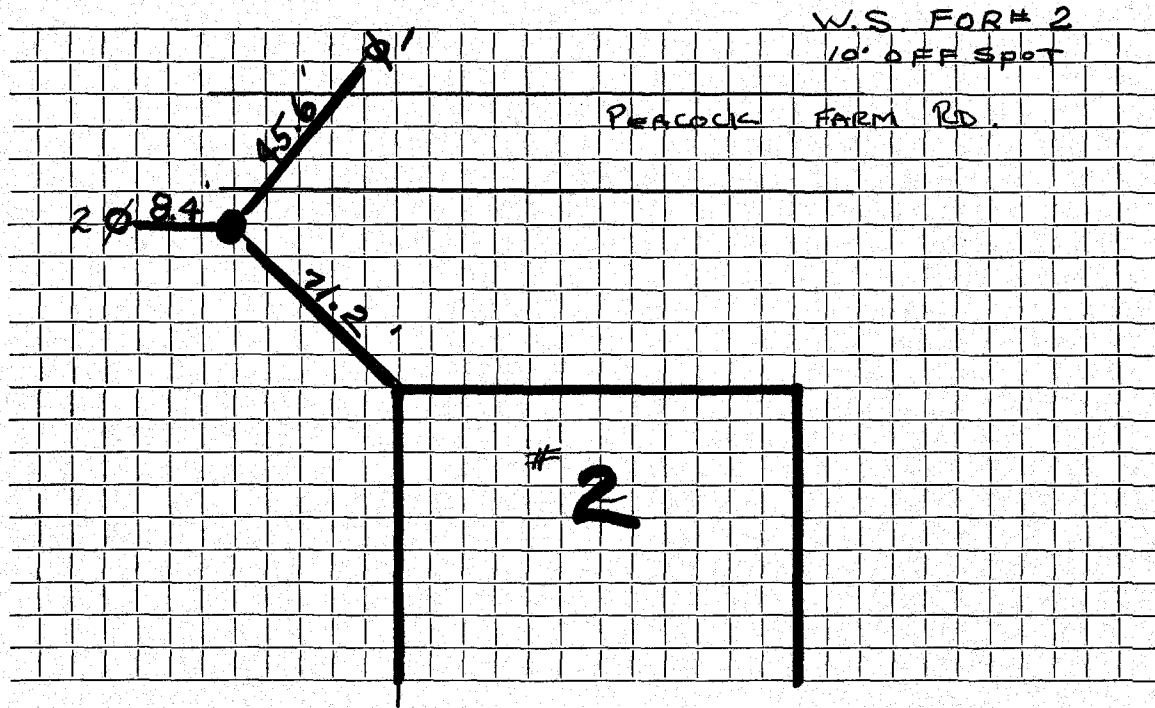

Connection made in Street. Work completed

Remarks:
.....
.....