

## WATER SERVICE RECORD

Name "The Marian Company"

Service No. 198

Address 23 Peacock Farm Road

Location

~~Repair~~ Renewal - New Service


Comm. 11-18-57

Date	Material	Amount	Total	Date	Amount
9/11/57	Labor	3 91		9-10-57	Deposit \$ 50 00
	10% overhead	39		11-18-57	Refund 22 74
			4 30		NON CHARGE \$ 27 26
	46' 3/4" copper tubing @ .375	17 25			NON CHARGE
	1 3/4" Cx 1/2 IWH stop & waste	4 96		11/23/56	Labor 1 95
	1 hr. trucking @ .75	75		25' 3/4" Copper tubing @ .4396	10 99
			27 26	1 3/4" C Corp Cock	4 64
				1 3/4" C Curb Cock	5 94
				1 Box & Rod	4 62
					28 14
				1 1/2 straight tail piece	50
				1 1/2 offset tail piece	50
					29 14

TOWN OF LEXINGTON — BOARD OF PUBLIC WORKS

WATER DIVISION

Sketch of Service Here

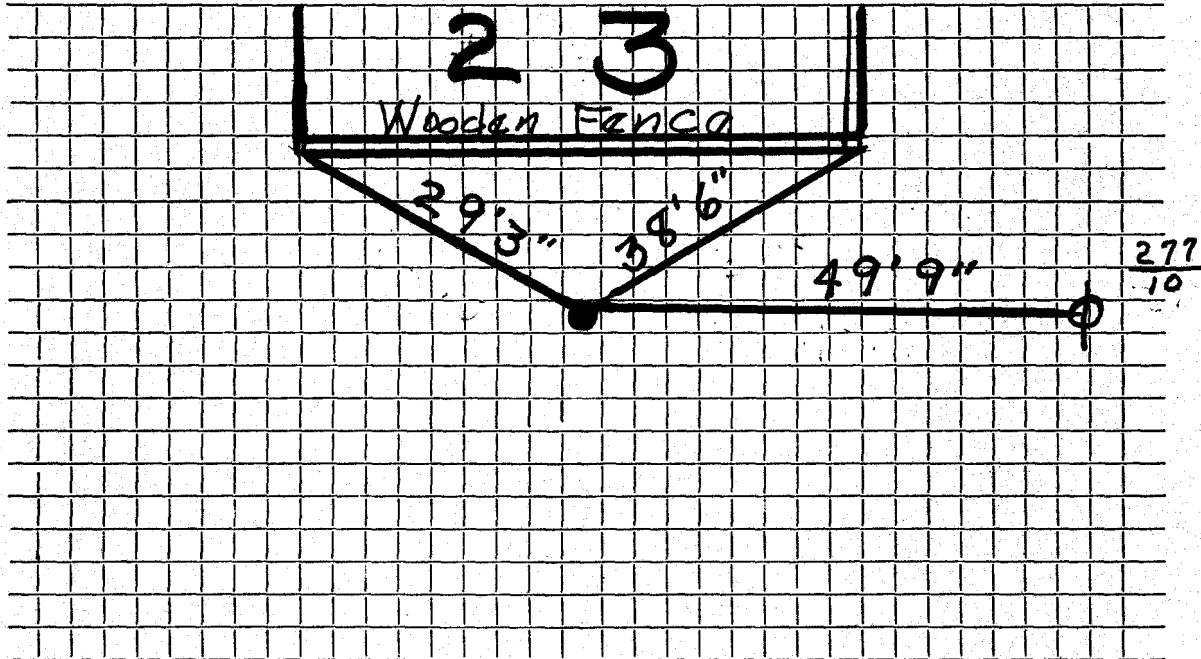

Connection made in ..... Street. Work completed .....

Remarks: .....

.....

.....