

WATER SERVICE RECORD

Name Benjamin Franklin Homes, Inc.

Service No. 353

Address 27 Peacock Farm Road


Location

~~Repair - Repair~~ - New Service

Date	Material	Amount	Total	Date	Amount
11/23/56	Labor	1 95		11-19-56	Deposit \$ 40 00
	10% overhead	20	2 15	12-31-56	Refund 3 14
	60' - 3/4" Copper tubing @ .4850	29 10			NON CHARGE 36 86
	1 - 3/4" Cx 1/2 I.W.H. Stop & Waste	4 96			
	1 hr. trucking		75		Labor 1 95
			36 86		30' - 3/4" Copper tubing @ .4850 14 55
					1 - 3/4" G. Corp Cock 4 64
					1 - 3/4" G. Curb Cock 5 94
					1 - 1/2 Straight tailpiece 50
					1 - 1/2 Offset tailpiece 50
					1 Box & Rod 4 62
					<u>32 70</u>

TOWN OF LEXINGTON — BOARD OF PUBLIC WORKS
WATER DIVISION

Sketch of Service Here

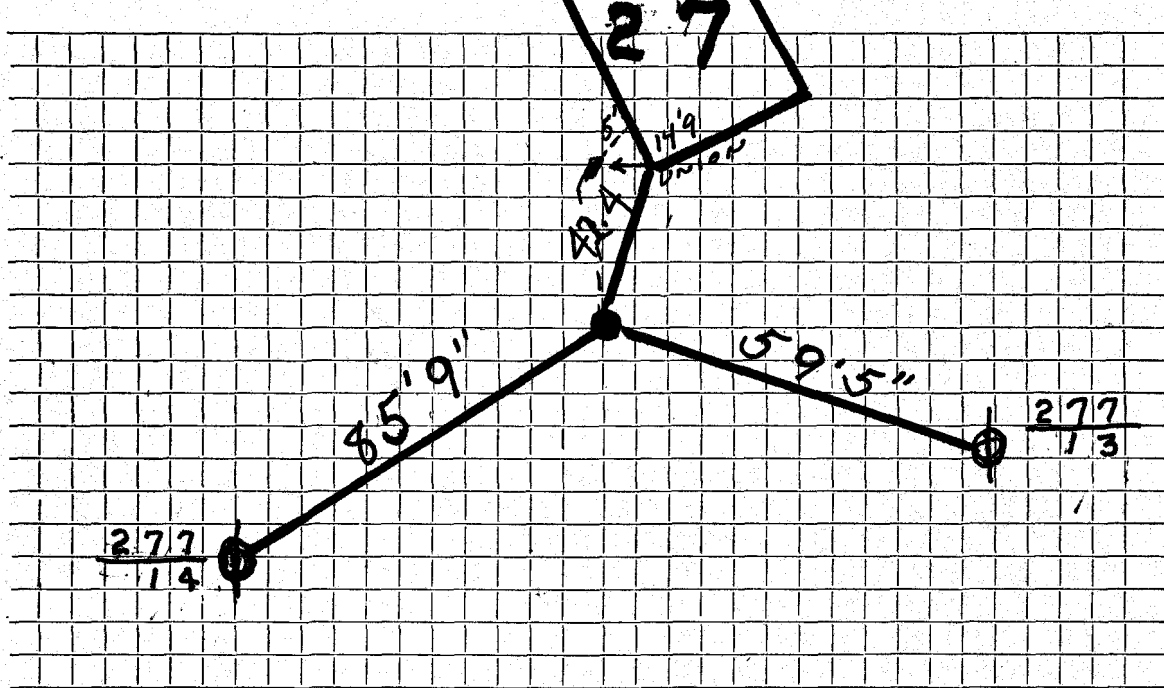

Connection made in Street. Work completed

Remarks:
.....
.....