

## WATER SERVICE RECORD

Name BEJAMIN FRANKLIN HOMES, INC.

Service No.

Address 29 Peacock Farm Road


Location

COMM 9-3-57~~Repair~~ Renewal - New Service

Date	Material	Amount	Total	Date	Amount
8-16-57	Labor	8 20		4-15 57	DEPOSIT 40 00
	10% OVERHEAD	82		9-12 57	PAID 10 82
	80' 3/4" COPPER TUBING @ .4228	33 82			50 82
	1 3/4" EX 1/2 I.W.H STW	4 96			<u>NON CHARGE</u>
	1 hr TRUCKING	75		11/21/56	Labor 1 95
	1 3/4" C. (3 PART) UNION	2 27		25 3/4"	Copper tubing @ .4396 10 99
		50 82		1 3/4" C	Corp Cock 4 64
				1 Union	3 Part 2 27
				1 3/4" C	Curb Cock 5 94
				1 Box & Rod	4 62
					30 41
				1-1/2	STRAIGHT TAILPIECE 50
				1-1/2	OFFSET TAILPIECE 50
					100
					BILL SENT 9-5-57

TOWN OF LEXINGTON — BOARD OF PUBLIC WORKS  
WATER DIVISION

Sketch of Service Here

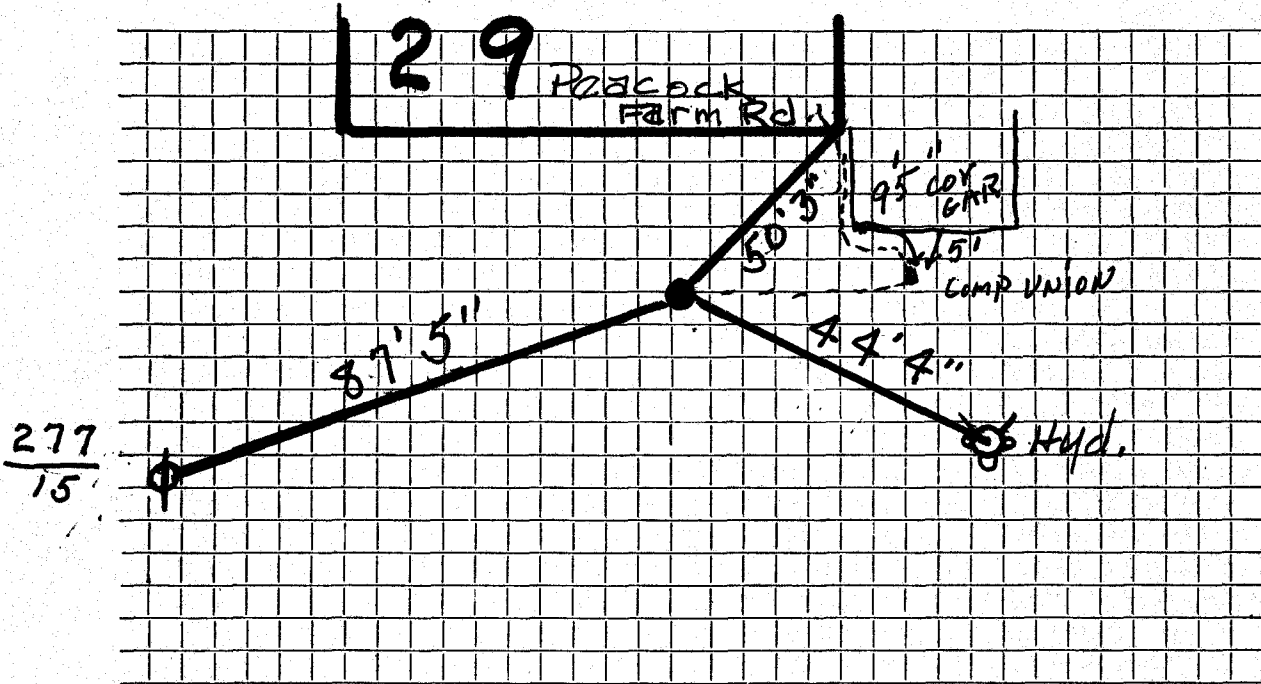

Connection made in ..... Street. Work completed .....

Remarks: .....

.....

.....