




TOWN OF LEXINGTON — BOARD OF PUBLIC WORKS

WATER DIVISION

Sketch of Service Here

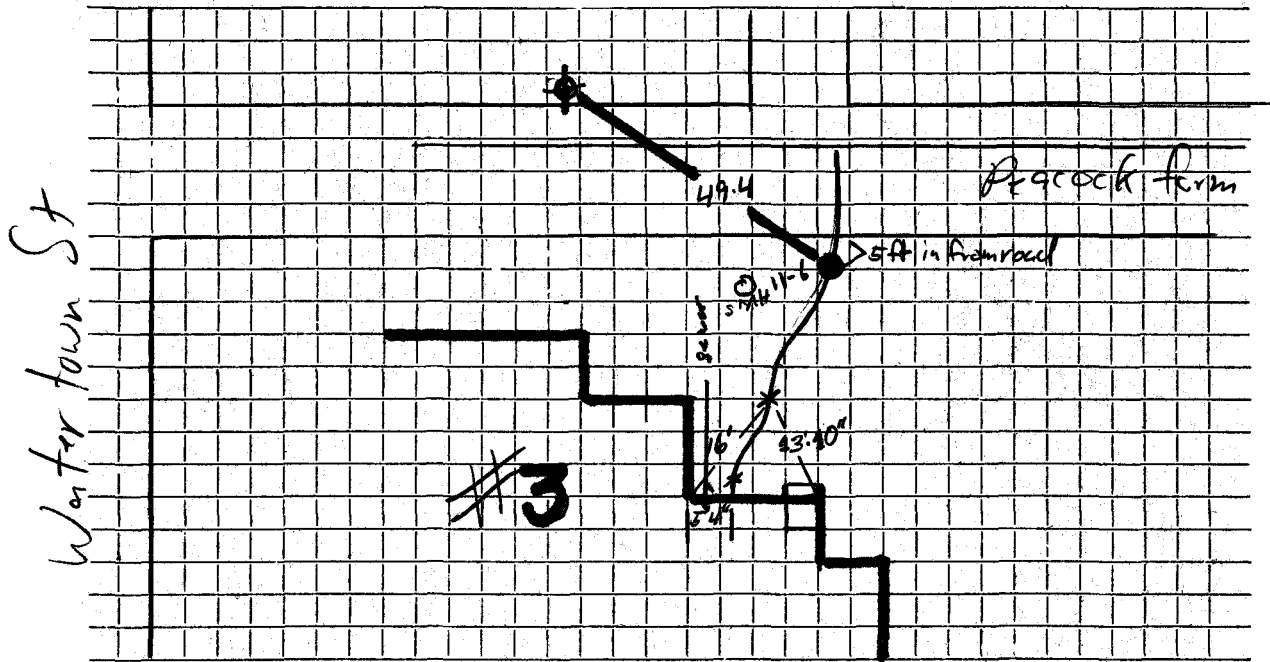

Connection made in Peacock Run Street. Work completed

Remarks: water service broken 11/30/92 first union is 6" outside of house second union is 13'-6" from house sewer service run out next to the water about 2 ft