

WATER SERVICE RECORD

Name

Service No.

Address

31 Peacock Farm Road

Location


~~Repair-Renewal~~—New Service

Date	Material	Amount	Total	Date	Amount
8-16-57					
	75' 3/4" Copper				
	1 3/4"C. X 1/2" l.w.H. STop + Waste				
	1 3/4"C. 3 Part Union				
					<u>NON CHARGE</u>
				11/21/56 Labor	1 95
				30' 3/4" Copper tubing @.4396	13 19
				1 3/4"C Corp Cock	4 64
				1 3/4"C Curb Cock	5 94
				1 Box & Rod	4 62
					30 34

TOWN OF LEXINGTON — BOARD OF PUBLIC WORKS

WATER DIVISION

Sketch of Service Here

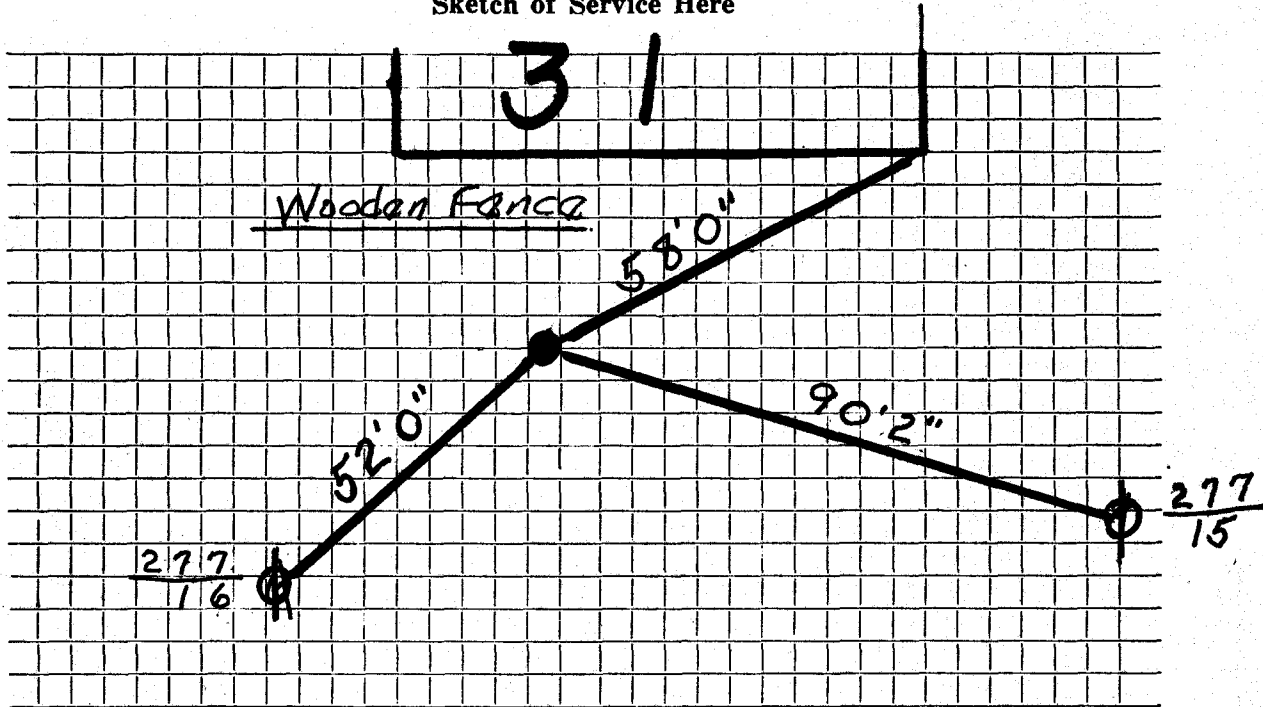

Connection made in Street. Work completed

Remarks:

.....

.....