

## WATER SERVICE RECORD

Name Benjamin Franklin Homes

Service No. 357

Address 33 Peacock Farm Road

Location

~~Repair~~ ~~Renewal~~ - New Service

Comm. 4/29/57


Date	Material	Amount	Total	Date	Amount
12-3-56	Labor	1.95		11-19-56	Deposit #40.00
	10% O.H.	.20	2.15	4-29-57	Refund \$ 8.40
	54' 3/4" Copper tubing @.4396		23.74		# 31.60
	1 3/4" C x 1/2 I.W.H. Stop & Waste		4.96		NON CHARGE
	1 hr. Trucking @.75		.75	23' 3/4" Copper tubing @.4396	10.11
			31.600	1 3/4" C Corp Cock	4.64
				1 3/4" C Curb Cock	5.94
				1 Box & Rod	4.62
				1 1/2 Straight tail piece	.50
				1 # Offset tail piece	.50
					28.26

A #7.50 Applied to W.N.C. #363

DATE \_\_\_\_\_

TOWN OF LEXINGTON — BOARD OF PUBLIC WORKS

WATER DIVISION

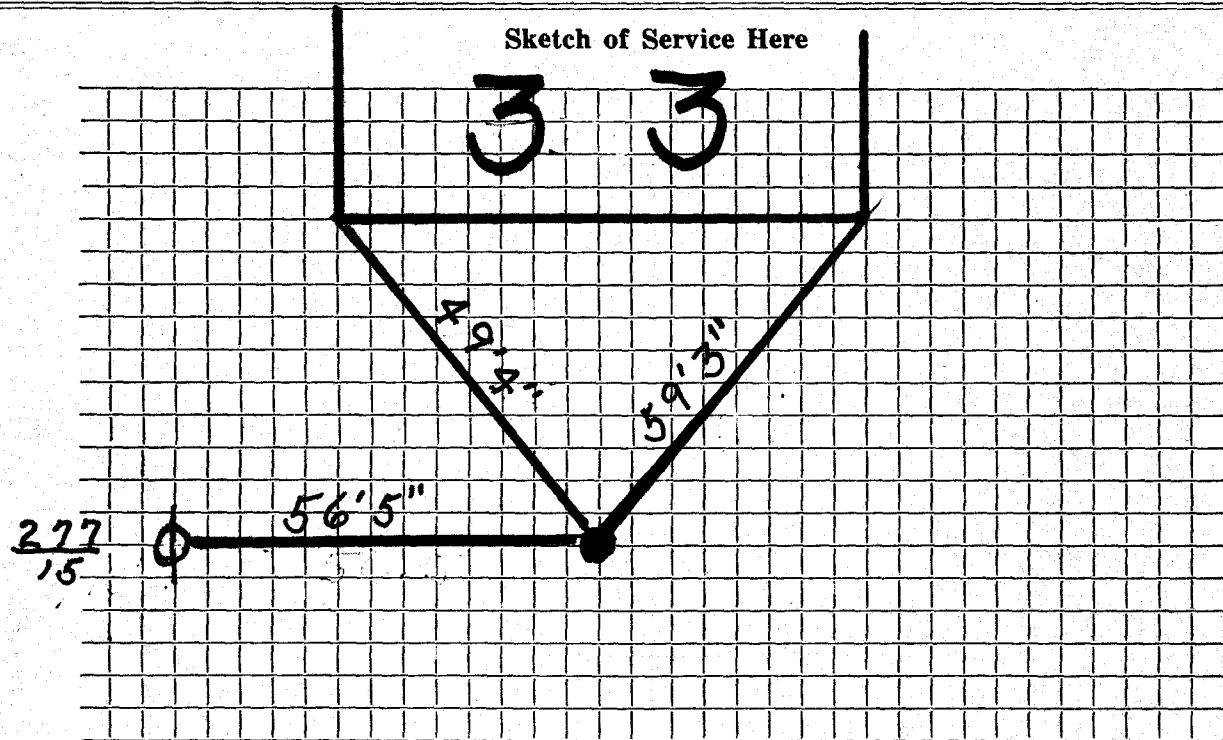

Connection made in ..... Street. Work completed .....

Remarks: .....

.....

.....