

WATER SERVICE RECORD

6136

Name Benjamin Franklin Homes

Service No. 359

Address 35 Peacock Farm Road

Location

~~Regular Service~~ - New Service

Comm. 4/29/57


Date	Material	Amount	Total	Date	Amount
12-3-56	Labor	1.95		11-19-56	Deposit \$40.00
	10% O.H.	.20	2.15	4-29-57	Refund 5.76
60'	3/4" Copper tubing @.4396	26.38	26.38		\$34.24
1	hr. Trucking @.75	.75	.75		NON CHARGE
1 -	3/4" Cx 1/2 I.W.H. Stop & Waste	34.96	34.96		Labor 1.95
			34.24		25' 3/4" Copper tubing @.4396 10.99
				1	3/4" C Corp Cock 4.64
				1	3/4" C Curb Cock 5.94
				1	Box & Rod 4.62
				1	1/2 Straight tail piece .50
				1	1/2 Offset tail piece .50
					29.14

DATE _____

TOWN OF LEXINGTON — BOARD OF PUBLIC WORKS

WATER DIVISION

Sketch of Service Here

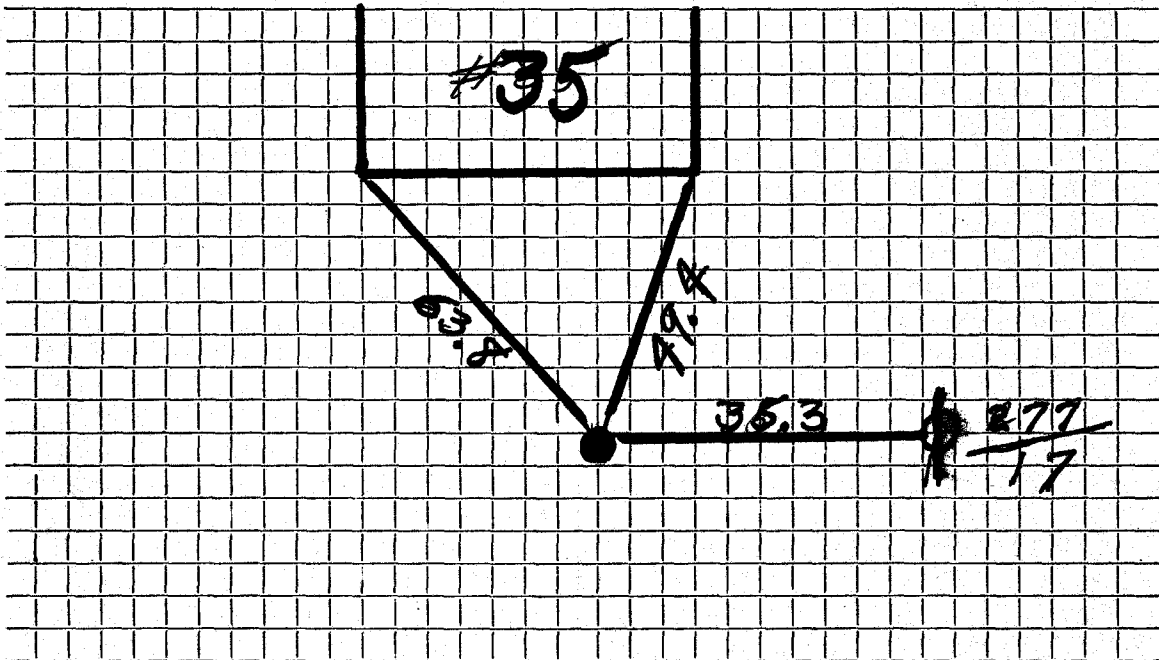

Connection made in Street. Work completed

Remarks:
.....
.....