

WATER SERVICE RECORD

812

Name Benjamin Franklin Homes, Inc.

Service No. 361

Address 39 Peacock Farm Road

(1956)

Location

~~Repair - Renewal~~ - New Service


Comm. 11-18-57

Date	Material	Amount	Total	Date	Amount
4/21/57	Labor	2 15		11-19-56	Deposit \$ 40 00
	10% overhead	22		11-18-57	Paid by refund on W.H.C. #168 (1957) \$ 11 36
			2 37		\$ 51 36
	97' 3/4" copper tubing @ .4228		41 01		NON CHARGE
	1 3/4" C x 1/2" IWH stop & waste		4 96	11/21/56	Labor 1 95
	1 hr trucking		75	30' 3/4" Copper tubing @ .4396	13 19
	1 3/4" C union 3 part		2 27	1 3/4" C Corp Cock	4 64
			51 36	1 3/4" C Curb Cock	5 94
				1 Box & Rod	4 62
				1 1/2" Straight Tail Piece	50
				1 1/2" Offset Tail Piece	50
					31 34

TOWN OF LEXINGTON — BOARD OF PUBLIC WORKS

WATER DIVISION

Sketch of Service Here

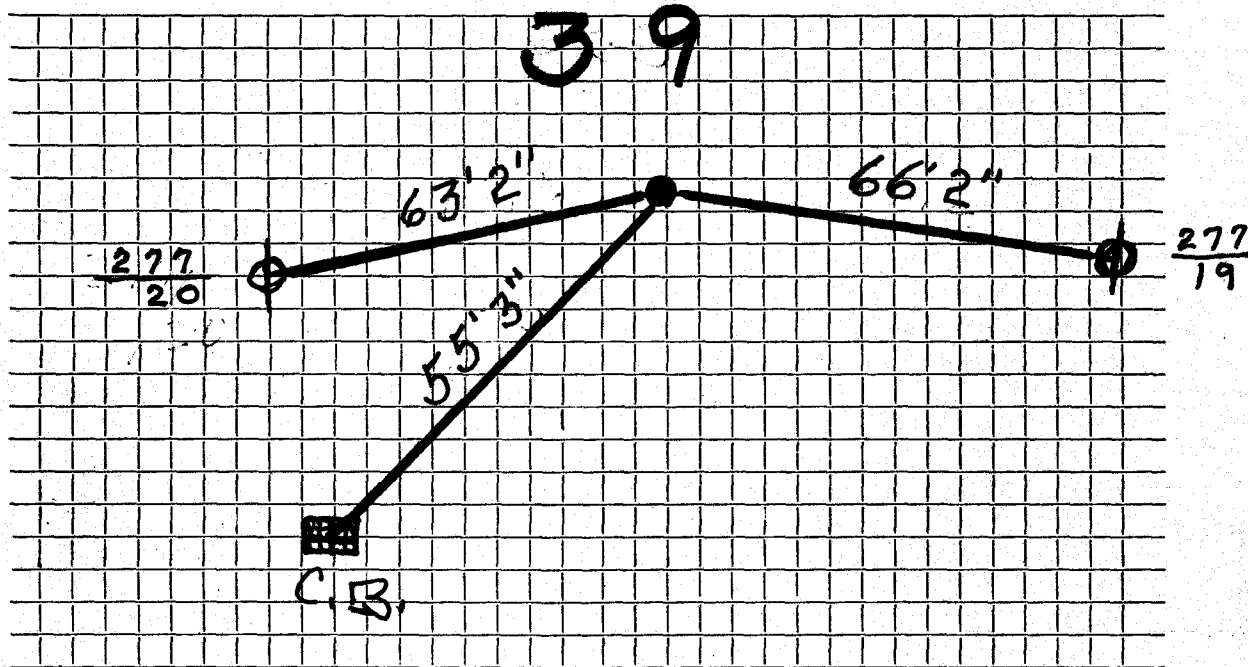

Connection made in Street. Work completed

Remarks: ..Curb Box... is laid over toward street... For a reason.....

.....
.....