

A. S. HEDGECOCK INC.

WATER SERVICE RECORD

Name Cambridge Corp.

Service No. 250

Address 4 Peacock Farm Road

Location

~~Renewed Service~~ - New Service

*Com. 9-14-53*

Date	Material	Amount	Total	Date	Amount
8/13/53	Labor	1 75		8-23-53	50 00
	10% overhead	18	1 93	9-24-53	1 95
	120' - 3/4" copper tubing @ .3629	43 55			<u>51 95</u>
	1 - 3/4" C x 1/2 I.W.H. stop & waste	4 00		8/13/53	Labor
	1 - 3/4" C x 3/4" C. union	1 72		10' - 3/4" copper tubing @ .3629	3 63
	<del>XXXXXX</del>			1 - 3/4" C. corp-cock	4 33
	1 hr. trucking		75	1 - 3/4" C x 3/4" C. curb-cock	4 67
			51 95	1 box and rod	3 90
	TRENCH DUG BY OWNER.			1 - 1/2 straight tail pc.	50
				1 - 1/2 offset tail pc.	50
				1 hr. trucking	75
					<u>20 03</u>


*bill sent 9-14-53*

DATE \_\_\_\_\_

TOWN OF LEXINGTON — BOARD OF PUBLIC WORKS

**WATER DIVISION**

Sketch of Service Here

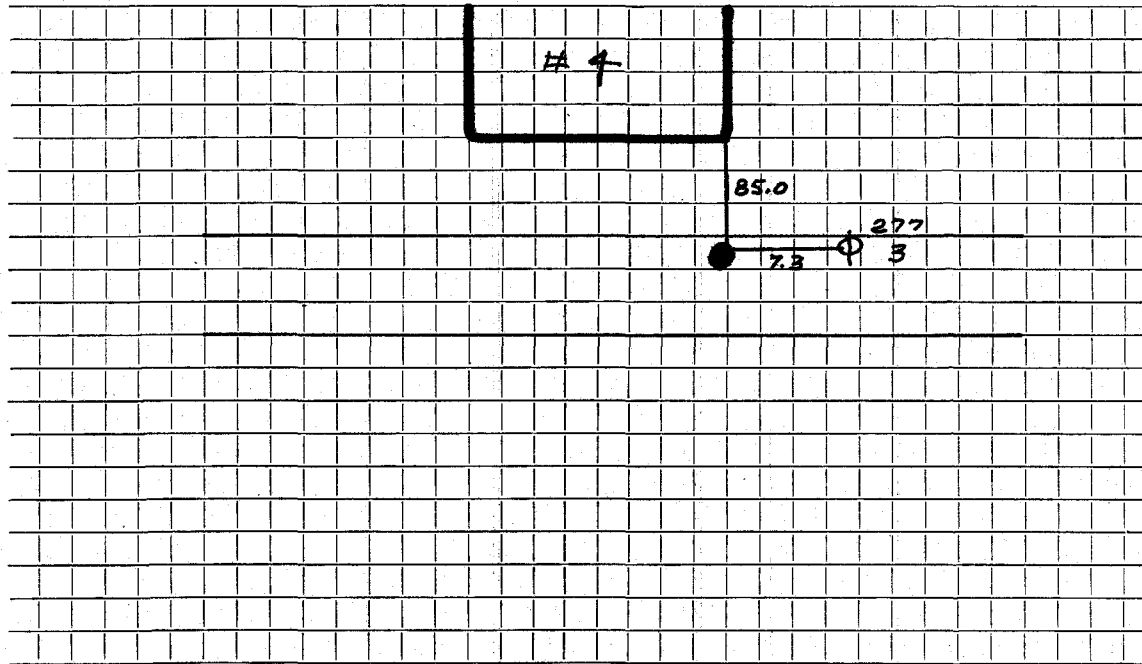

Connection made in ..... Street.      Work completed .....

Remarks: .....

.....

.....