

WATER SERVICE RECORD

Name Benjamin Franklin Homes

Service No. 363

Address 41 Peacock Farm Road

#7601

Location

~~Repair - Renewal~~ New Service

Comm. 4/29/57


Date	Material	Amount	Total	Date	Amount
12-3-56	Labor	1.95		11-19-56	Deposit \$ 40 00
	10% O.H.	.20	2.15	4-29-57	Paid by refund on w. h. @ # 367 \$ 7 50
	85' 3/4" Copper tubing @.4396		37.37		\$ 47 50
	1 3/4" C x 1/2 I.W.H. Stop & Waste		4.96		NON CHARGE
	1 3/4" Union 3 Part		2.27		Labor
	1 Hr. Trucking @.75		.75		10.95
			47.50	25'	3/4" Copper tubing @.4396 10.99
				1	3/4" C Corp Cock 4.64
				1	3/4" C Curb Cock 5.94
				1	Box & Rod 4.62
				1	1/2 Straight tail piece .50
				1	1/2 Offset tail piece .50
					29.14

DATE _____

TOWN OF LEXINGTON — BOARD OF PUBLIC WORKS

WATER DIVISION

Sketch of Service Here

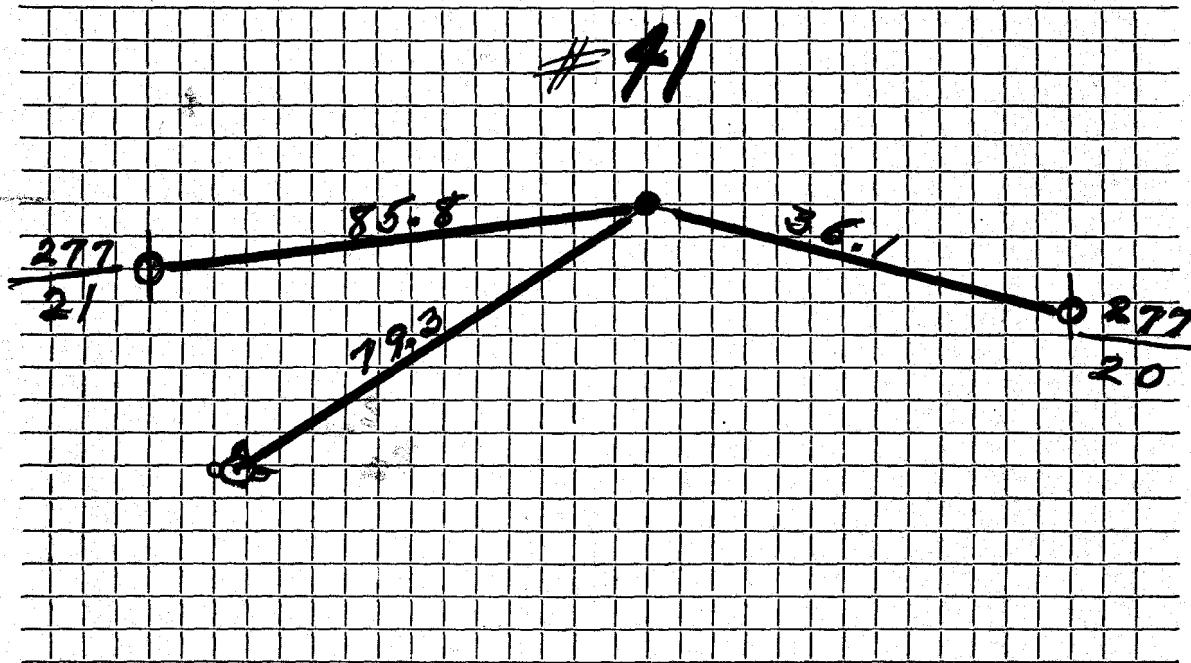

Connection made in Street. Work completed

Remarks:

.....

.....