

#4006

WATER SERVICE RECORD

Name Benjamin Franklin Homes

Service No. 242

Address 42 Peacock Farm Road

Location

Report Newark New Service


Comm. 12-9-57

Date	Material	Amount	Total	Date		Amount
10/24/57	labor	3 27		10-22-57	Deposit	\$ 40.00
	10% overhead	33		12-2-57	Refund	\$ 9.62
			3 60			\$ 30.31
56' 3/4" copper tubing @ .375		21 00			NON CHARGE	
1 3/4" Cx $\frac{1}{2}$ IWH stop & waste		4 96		labor		3 28
1 hr. trucking @ .75		75		25' 3/4" copper tubing @ .375	9 38	
		30 31		1 3/4" C corp cock		4 64
				1 3/4" C curb cock		5 94
				1 box & rod		4 62
				1 $\frac{1}{2}$ straight tail pc.		50
				1 $\frac{1}{2}$ offset tail pc.		50
						28 86

DATE 10-24-57

TOWN OF LEXINGTON — BOARD OF PUBLIC WORKS
WATER DIVISION

Sketch of Service Here

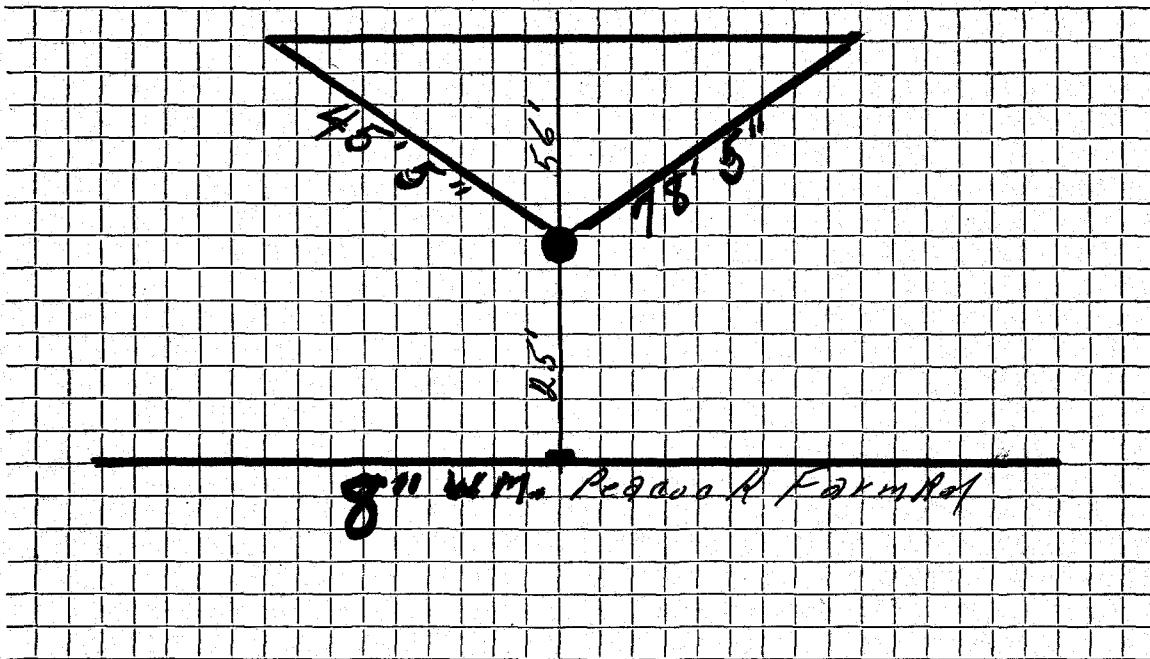

Connection made in 42 Ped. on N. Farm Rd. Street.

Work completed

Remarks:

.....