

WATER SERVICE RECORD

#466

Name Benjamin Franklin Homes, Inc.

Service No. 247

Address 43 Peacock Farm Road

Location

~~Repair~~ - New Service


Comm. 12-2-57

Date	Material	Amount	Total	Date	Amount
10/23/57	labor	3 27		10-22-57	Deposit \$40.00
	10% overhead	33		12-2-57	Refund 9 69
			3 60		\$30 31
	56' 3/4" copper tubing @.375		21 00		NON CHARGE
	1 3/4" Cx 1/2 IWH stop & waste		4 96		labor 3 28
	1 hr. trucking @ .75		75		25' 3/4" copper tubing @.375 9 38
			30 31		1 3/4" C corp cock 4 64
					1 3/4" C curb cock 5 94
					1 box & rod 4 62
					1 1/2 straight tail pc. 50
					1 1/2 offset tail pc. 50
					28 86
					* \$2.33 applied to w.H.C. #246

DATE \_\_\_\_\_

**TOWN OF LEXINGTON — BOARD OF PUBLIC WORKS**  
**WATER DIVISION**

Sketch of Service Here

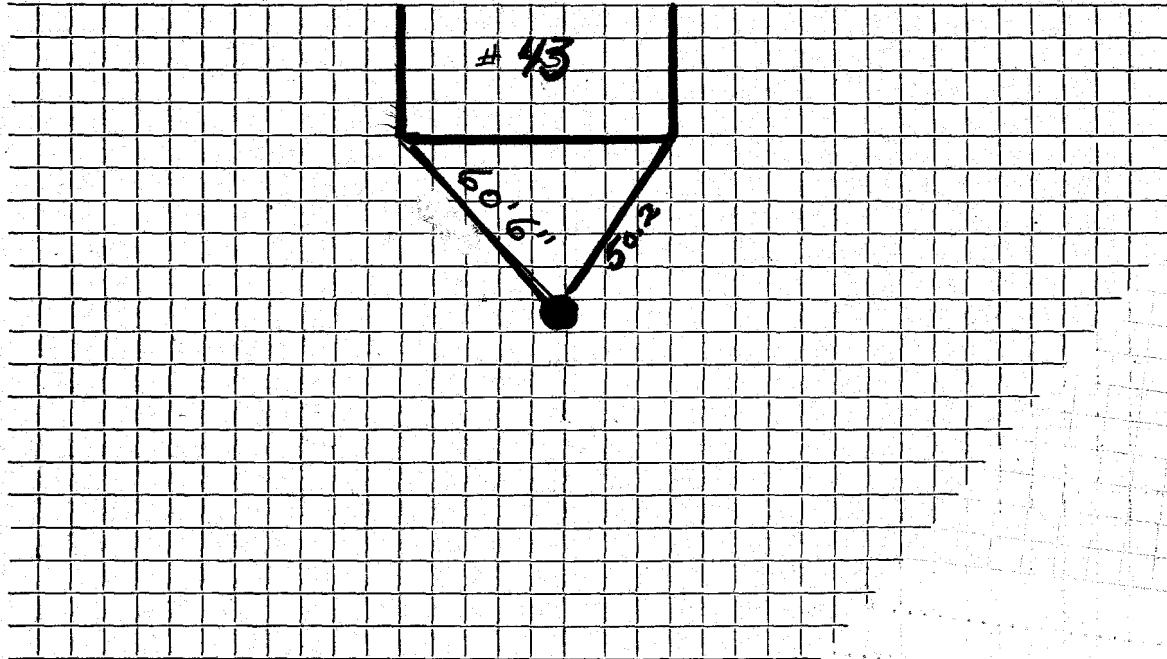

Connection made in ..... Street.

Work com .....

Remarks: .....

.....  
.....