
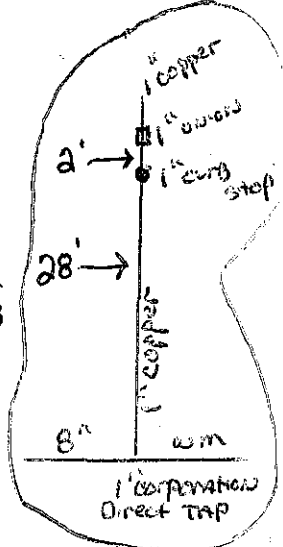


DATE 10-19-20

TOWN OF LEXINGTON — BOARD OF PUBLIC WORKS

WATER DIVISION

Sketch of Service Here

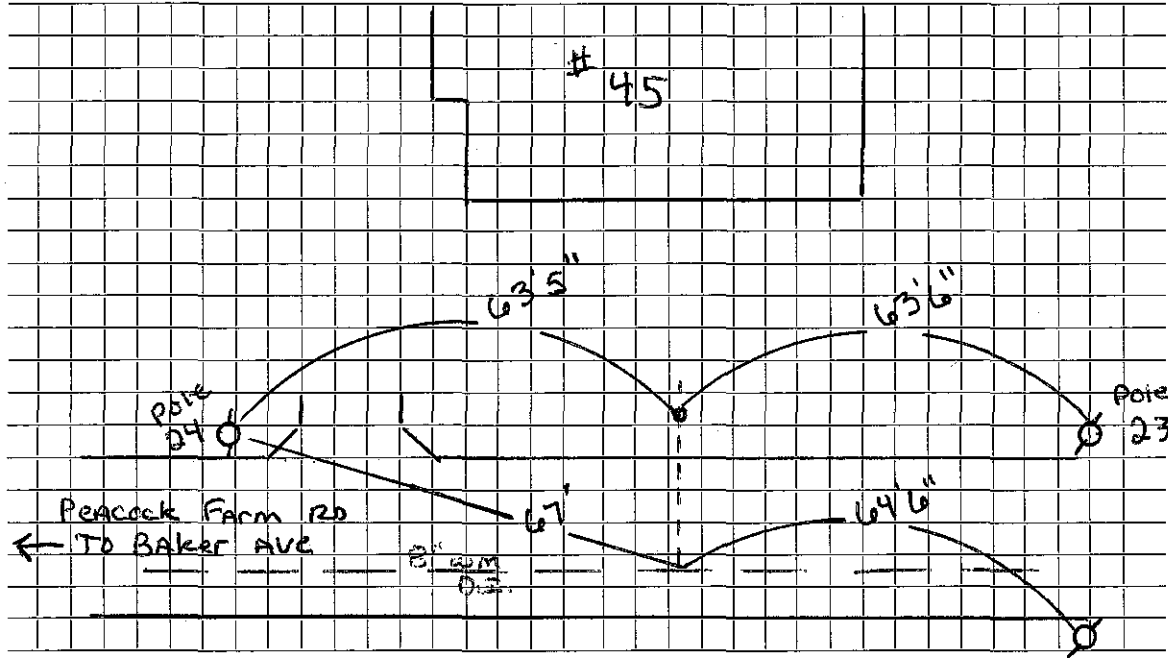

Connection made in Street.

Work completed ~~Installed~~ new manv. to curb stop.

Remarks:

.....

.....