
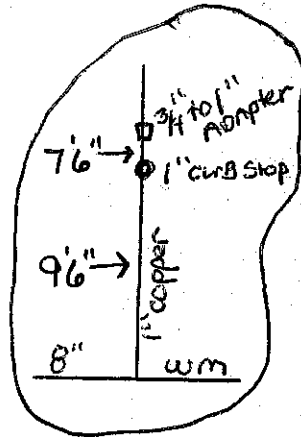


DATE 10-20-20

TOWN OF LEXINGTON — BOARD OF PUBLIC WORKS

WATER DIVISION

Sketch of Service Here

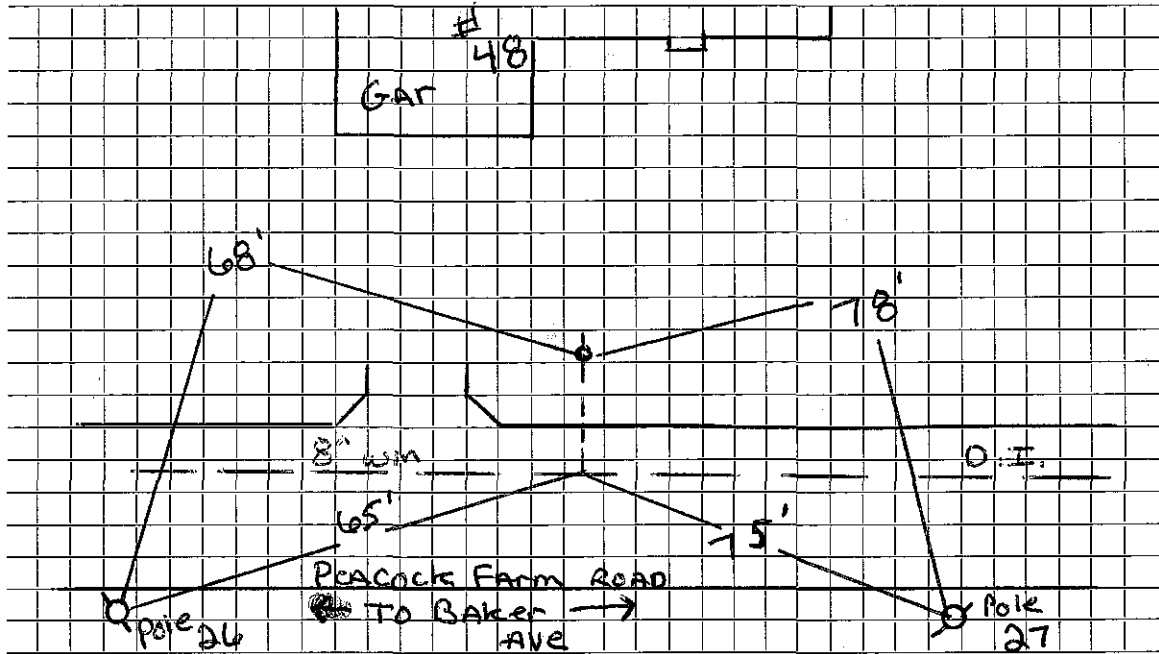

Connection made in Street.

Work completed ~~Installed~~ . New main to curb stop

Remarks:

.....

.....