

DATE _____

TOWN OF LEXINGTON — BOARD OF PUBLIC WORKS
WATER DIVISION

Sketch of Service Here

A large grid of graph paper, consisting of 20 columns and 20 rows, intended for sketching service details.

Connection made in Street. Work completed

Remarks: SERVICE TO EDGE OF Rd. NOT USED

.....
.....

WATER SERVICE RECORD

Name

Service No.

Address

49 Peacock Farm Road

Location

Lot 56

~~REPAIR - REPAIR~~

New Service

Date	Material	Amount	Total	Date	Material	Amount	Total
					NON CHARGE		
				11/1/57	Labor	4	57
				22'	3/4" Copper tubing @.375	8	25
				1	3/4" C Corp Cock	4	64
				1	3/4" C Curb Cock	5	94
				1	Box & Rod	4	62
						28	02


DATE _____

TOWN OF LEXINGTON — BOARD OF PUBLIC WORKS

WATER DIVISION

Sketch of Service Here

WATER SERVICE
FOR # 49
PEACOCK FARM ROAD

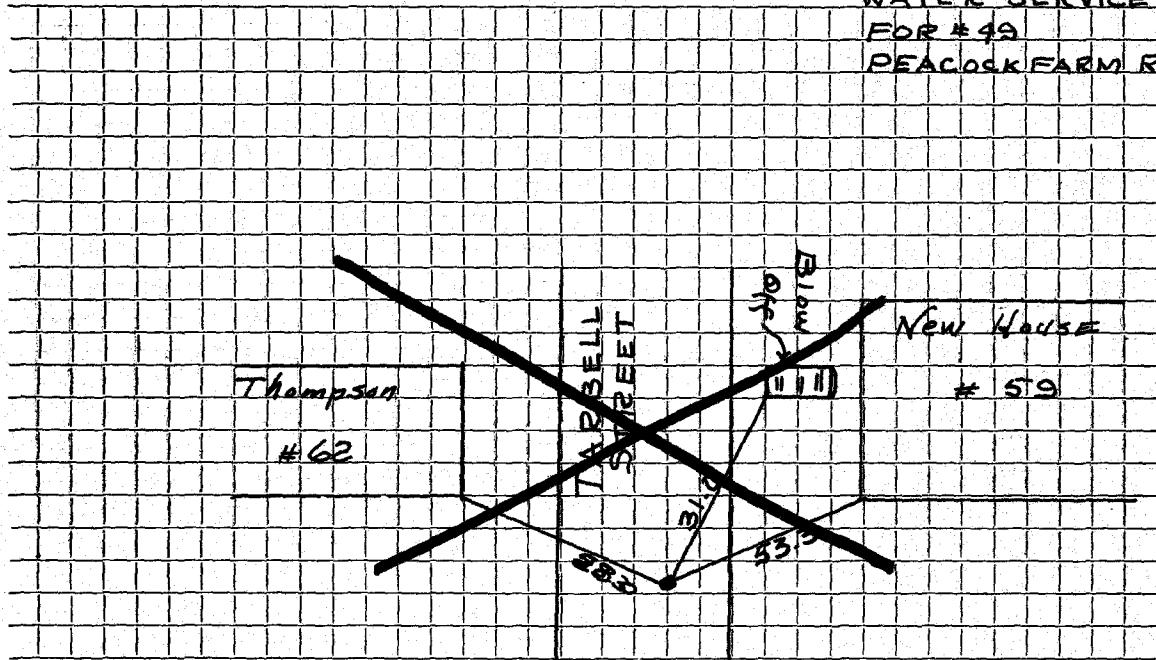

Connection made in Street. Work completed

Remarks: Service To edge of road NOT used.....